

MISSISSIPPI DEPARTMENT OF NATURAL RESOURCES

Bureau of Land and Water Resources

Southport Mall

P.O. Box 10631

Jackson, Mississippi 39209

WATER WELL DRILLERS LOG

STONE
C 2095

3-24-19 date well completed

810 Frank Price firm name

Stone county well located

LANDOWNER:
Roger White

(mailing address)

WELL LOCATION:
sec. 21 T. 2 N. R. 11 E. S. 1 W.
2 miles E Wiggins (distance) (direction) (nearest town)

WELL PURPOSE: HOME (home, irrigation, municipal, industrial)

WELL COMPLETION DATA:

(1) diameter (inches) 2"

(2) total depth (feet) 85"

(3) static water level (feet) 40' below top of ground.

(4) casing PVC 80' (material) (depth)

(size) if telescope see back.

(5) screen 5' 80' (length) (depth to top)

2" PVC (size) (material)

(6) pump 1 (HP) 9 (yield gpm)


Elect. (type power)

(7) electric log no (yes or no)

(organization running log)

(8) how well bottom plugged B.W.Y.

description of formations encountered	depth	
	from	to
Top Soil	0	1
Red Clay	1	8
Blue Sand	8	25
Clay	25	75
Coarse Sand	75	85

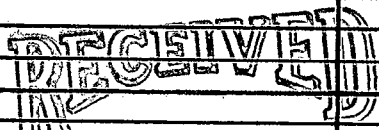


AUG 18 1996

Department of Natural Resources
Bureau of Land & Water Resources

DRILLERS REMARKS:

If well telescopes please sketch and show depths.

GROUND LEVEL

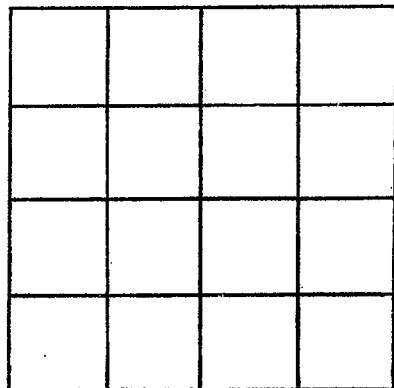

SECTION _____

Please indicate well location X.

ADDITIONAL INFORMATION

If more than one screen,
show locations of each on sketch.