

MISSISSIPPI DEPARTMENT OF NATURAL RESOURCES

Bureau of Land and Water Resources

Southport Mall

P.O. Box 10631

Jackson, Mississippi 39209

WATER WELL DRILLERS LOG

STONE
C 2096

12-2
date well completed

Frank Price Stone
firm name

county well located

LANDOWNER:

Ken Latt

(mailing address)

WELL LOCATION:

sec. 13 T-2 S R-11
1 1/2 miles N of White-Crossing
(distance) (direction) (nearest town)

WELL PURPOSE: HOME
(home, irrigation, municipal, industrial)

WELL COMPLETION DATA:

- (1) diameter (inches) 2"
- (2) total depth (feet) 105'
- (3) static water level (feet) 60' below top of ground.
- (4) casing PVC, 100' (material) (depth)
- (size) if telescope see back.
- (5) screen 5', 100' (length) (depth to top)
- 2" PVC (size) (material)
- (6) pump 1 (HP) 9 (yield gpm)
- Elect (type power)
- (7) electric log no (yes or no)
- (organization running log)

(8) how well bottom plugged

BWV

DRILLERS REMARKS:

description of formations encountered

from to

Top Soil	0	1
Sandy Clay	1	28
Fine Sand	28	56
Coarse Sand	56	105


RECEIVED

OCT 15 1987

Department of Natural Resources
Bureau of Land & Water Resources

If well telescopes please sketch and show depths.

GROUND LEVEL

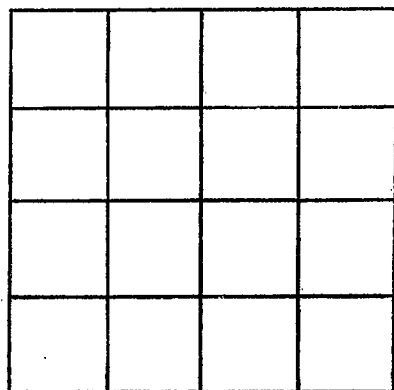

SECTION _____

Please indicate well location X.

ADDITIONAL INFORMATION

If more than one screen, show locations of each on sketch.