

MISSISSIPPI DEPARTMENT OF ENVIRONMENTAL QUALITY

Office of Land and Water Resources

P. O. Box 10631  
Jackson, MS 39289-0631  
WATER WELL DRILLERS LOG

COUNTY WELL LOCATED  
**STONE**

WELL NUMBER **C2100** CODED

**\$2994**

DATE WELL COMPLETED

PERMIT NUMBER  
**0408**

NAME OF DRILLING FIRM  
**Fryfogle Well Ser.**  
*PT 3 Box 3*  
*Sumner MS 39452*

NAME & MAILING ADDRESS OF LANDOWNER  
**John & Mary B Hill**  
**565 Kirtell Loop**  
**Beaumont MS 39423**

WELL LOCATION SEC TOWNSHIP RANGE  
**1 42 N R 11 E W**

DISTANCE DIRECTION NEAREST TOWN  
**3** Miles **East** of **Wiggins**

OTHER LANDMARK  
*the*

WELL PURPOSE *Home, Irrigation, Municipal, Industrial, Fish Pond, etc.*

PUMP DATA

PUMP TYPE (Circle One):  
Submersible, Turbine, **Jet** Flowing Well,  
Other (Describe) \_\_\_\_\_

POWER TYPE (Circle One):  
**Electric** Tractor, Diesel, Gasoline, Butane,  
Other (Describe) **1** H/P \_\_\_\_\_

Pump Capacity (GPM) No. of Stages Setting Depth  
**10** **2** **80'** FT.

PUMPEST

Well yielded **10** GPM with  
a drawdown of **10** ft.  
after **1 1/2** hours of pumping

WELL DATA

Well Depth <b>184'</b>	Casing Diameter (In.) <b>2"</b>	Casing Length (Ft.) <b>164'</b>
Type of Casing <b>PVC</b>	Hole Depth <b>184</b>	Depth to Static Water Level <b>65</b>

LOG DATA

TYPE OF LOG RUN (Circle One):  
No Log Run, Electric, Gamma Ray, Density, Sonic, Neutron,  
Other (Describe) \_\_\_\_\_

Name of Organization Running Log

TYPE OF COMPLETION: (Circle One or More):  
Gravel Packed, Underreamed, Telescoped,  
Natural Development, Open Hole, Other  
(Describe) \_\_\_\_\_

GEOLOGIC DATA (Office Use Only)

Surface Elev.	Geologic Unit	Unit Thickness	Depth to Top
Subs. SWL	Date	Analysis	Aquifer Test

WELL GROUTED TO A DEPTH OF \_\_\_\_\_ FEET  
Type Grout (circle one): Cement, Bentonite, or Mix

Driller's Remarks

Top of Lap Pipe or Reduction in Casing

FEET IF TELESKOPED OR MORE THAN ONE SCREEN: USE BACK PAGE

SCREEN DATA

Diameter - Inches <b>2"</b>	Length - Feet <b>16</b>	Slot Size - Inches <b>#6</b>
Screen Type <b>PVC, wrapped</b>	Depth to Bottom - Feet <b>184'</b>	

DESCRIPTION OF FORMATIONS ENCOUNTERED	FROM	TO
<i>Top Soil</i>	<i>0</i>	<i>5</i>
<i>Clay</i>	<i>5</i>	<i>20</i>
<i>Clay</i>	<i>20</i>	<i>40</i>
<i>Clay</i>	<i>40</i>	<i>80</i>
<i>Clay</i>	<i>80</i>	<i>120</i>
<i>Shred Spiny Sand</i>	<i>120</i>	<i>140</i>
<i>med clay</i>	<i>140</i>	<i>150</i>
<i>med sand</i>	<i>150</i>	<i>184</i>

FORMATIONS (Continued)

FROM	TO

**RECEIVED**


**AUG 15 1994**

Dept. of Environmental Quality  
Office of Land & Water Resources

IF MORE SPACE IS NEEDED, USE BACK

If well telescopes please sketch and show depths.

GROUND LEVEL

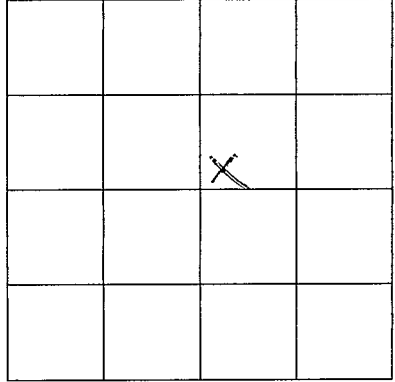

SECTION 4

Please indicate well location X.

ADDITIONAL INFORMATION

If more than one screen,  
show location of each on sketch.