

**MISSISSIPPI DEPARTMENT OF ENVIRONMENTAL QUALITY**

Office of Land and Water Resources

P. O. Box 10631

Jackson, MS 39289-0631

**WATER WELL DRILLERS LOG**

COUNTY WELL LOCATED <b>Stone</b>	
WELL NUMBER <b>C</b>	CODED
DATE WELL COMPLETED <b>2109</b> <b>11-4-94</b>	

PERMIT NUMBER
NAME OF DRILLING FIRM <b>Boone Water Well</b>

NAME & MAILING ADDRESS OF LANDOWNER <b>Jerry Parson</b>			
WELL LOCATION <b>Wiggins</b>			
SEC <b>27</b>	TOWNSHIP <b>2</b>	RANGE <b>N 11 E</b>	
DISTANCE <b>2</b> Miles	DIRECTION <b>E</b>	NEAREST TOWN <b>Wigg</b>	
OTHER LANDMARK			
WELL PURPOSE <input checked="" type="checkbox"/> Home Irrigation, Municipal, Industrial, Fish Pond, etc.			

PUMP DATA		
PUMP TYPE (Circle One): <input checked="" type="checkbox"/> Submersible Turbine, Jet, Flowing Well, Other (Describe) _____		
POWER TYPE (Circle One): <input checked="" type="checkbox"/> Electric Tractor, Diesel, Gasoline, Butane, Other (Describe) _____ H/P <b>1</b>		
Pump Capacity (GPM)	No. of Stages	Setting Depth  <b>FT.</b>
PUMP TEST		
Well yielded _____ GPM with a drawdown of _____ ft. after _____ hours of pumping		

WELL DATA		
Well Depth <b>85</b>	Casing Diameter (In.) <b>4</b>	Casing Length (Ft.) <b>65</b>
Type of Casing <b>sch 40</b>	Hole Depth <b>85</b>	Depth to Static Water Level
TYPE OF COMPLETION: (Circle One or More): <input checked="" type="checkbox"/> Gravel Packed, Underreamed, Telescoped, Natural Development, Open Hole, Other (Describe) _____		
WELL GROUTED TO A DEPTH OF <b>5</b> FEET Type Grout (circle one): <input checked="" type="checkbox"/> Cement, Bentonite, or Mix		

LOG DATA	
TYPE OF LOG RUN (Circle One): No Log Run, Electric, Gamma Ray, Density, Sonic, Neutron, Other (Describe) _____	
Name of Organization Running Log	


SCREEN DATA		
Diameter - Inches <b>4</b>	Length - Feet <b>20</b>	Slot Size - Inches <b>8</b>
Screen Type <b>sch 40</b>	Depth to Bottom - Feet	

GEOLOGIC DATA (Office Use Only)			
Surface Elev.	Geologic Unit	Unit Thickness	Depth to Top
Subs. SWL	Date	Analysis	Aquifer Test
Driller's Remarks			

DESCRIPTION OF FORMATIONS ENCOUNTERED	FROM	TO	FORMATIONS (Continued)	FROM	TO
<b>Clay</b>	<b>0</b>	<b>15</b>	<b>RECEIVED</b>		
<b>Sand</b>	<b>15</b>	<b>85</b>			
			<b>JUN 12 1995</b>		
			Dept. of Environmental Quality Office of Land & Water Resources		
			IF MORE SPACE IS NEEDED, USE BACK		

If well telescopes please sketch and show depths.

GROUND LEVEL

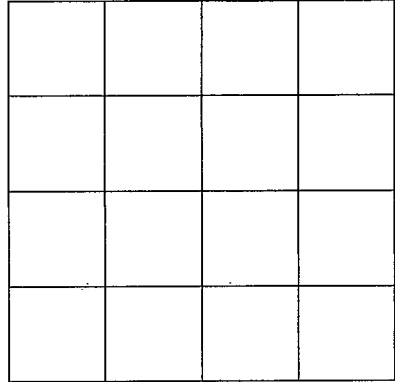

SECTION \_\_\_\_\_  
Please indicate well location X.

ADDITIONAL INFORMATION

If more than one screen,  
show location of each on sketch.