

MISSISSIPPI DEPARTMENT OF ENVIRONMENTAL QUALITY

Office of Land and Water Resources

P. O. Box 10631
Jackson, MS 39289-0631
WATER WELL DRILLERS LOG

COUNTY WELL LOCATED <i>Stone</i>	
WELL NUMBER <i>C</i>	CODED
DATE WELL COMPLETED <i>11-17-94</i>	

PERMIT NUMBER
NAME OF DRILLING FIRM <i>BOONE Water Well</i>

NAME & MAILING ADDRESS OF LANDOWNER <i>David White</i>			
<i>Hywy 26 E. Wiggins</i>			
WELL LOCATION:	SEC <i>29</i>	TOWNSHIP <i>2</i>	RANGE <i>11</i>
DISTANCE <i>3</i>	DIRECTION <i>E</i>	NEAREST TOWN <i>Wiggins</i>	
OTHER LANDMARK			
WELL PURPOSE: <input checked="" type="radio"/> Home Irrigation, Municipal, Industrial, Fish Pond, etc.			

PUMP DATA		
PUMP TYPE (Circle One): <input checked="" type="radio"/> Submersible, Turbine, Jet, Flowing Well, Other (Describe) _____		
POWER TYPE (Circle One): <input checked="" type="radio"/> Electric, Tractor, Diesel, Gasoline, Butane, Other (Describe) _____ H/P _____		
Pump Capacity (GPM)	No. of Stages	Setting Depth FT.
PUMP TEST		
Well yielded _____ GPM with a drawdown of _____ ft. after _____ hours of pumping		

WELL DATA		
Well Depth <i>385</i>	Casing Diameter (In.) <i>4</i>	Casing Length (Ft.) <i>365</i>
Type of Casing <i>sch 40</i>	Hole Depth <i>385</i>	Depth to Static Water Level <i>155</i>
TYPE OF COMPLETION: (Circle One or More): <input checked="" type="radio"/> Gravel Packed, Underreamed, Telescoped, Natural Development, Open Hole, Other (Describe) _____		
WELL GROUTED TO A DEPTH OF <i>5</i> FEET Type Grout (circle one): <input checked="" type="radio"/> Cement, Bentonite, or Mix		

LOG DATA	
TYPE OF LOG RUN (Circle One): Electric, Gamma Ray, Density, Sonic, Neutron, Other (Describe) _____	
Name of Organization Running Log	

SCREEN DATA		
Diameter - Inches <i>4</i>	Length - Feet <i>20</i>	Slot Size - Inches <i>8</i>
Screen Type <i>sch 40</i>	Depth to Bottom - Feet	


GEOLOGIC DATA (Office Use Only)			
Surface Elev.	Geologic Unit	Unit Thickness	Depth to Top
Subs. SWL	Date	Analysis	Aquifer Test
Driller's Remarks			

DESCRIPTION OF FORMATIONS ENCOUNTERED	FROM	TO
<i>Sandy Clay</i>	<i>0</i>	<i>10</i>
<i>Sand</i>	<i>10</i>	<i>60</i>
<i>Gravel Clay</i>	<i>60</i>	<i>355</i>
<i>Same</i>	<i>355</i>	<i>385</i>

FORMATIONS (Continued)	FROM	TO
RECEIVED		
JUN 12 1995		
Dept. of Environmental Quality Office of Land & Water Resources		
IF MORE SPACE IS NEEDED, USE BACK		

If well telescopes please
sketch and show depths.

GROUND LEVEL

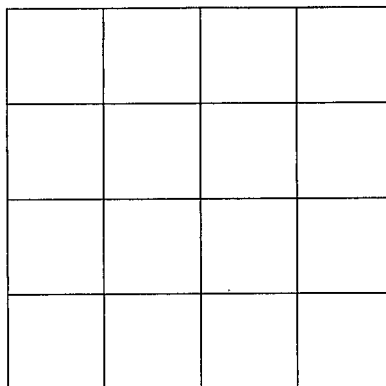

SECTION _____

Please indicate well location X.

ADDITIONAL INFORMATION

If more than one screen,
show location of each on sketch.