

MISSISSIPPI DEPARTMENT OF NATURAL RESOURCES

Bureau of Land and Water Resources

Southport Mall

P.O. Box 10631

Jackson, Mississippi 39209

WATER WELL DRILLERS LOG

~~STONE~~
~~Wiggins~~
 C 2114
 9-4-81

9-4-1981 date well completed *Parnee Anderson Stone* firm name county well located

LANDOWNER: *H. J. Lott*
Rt. 1
Wiggins MS
 (mailing address)

description of formations encountered	from	to
<i>Top Soil</i>	<i>0</i>	<i>3</i>
<i>Clay</i>	<i>3</i>	<i>22</i>
<i>Sand</i>	<i>22</i>	<i>54</i>
<i>Clay</i>	<i>54</i>	<i>98</i>
<i>Sand</i>	<i>98</i>	<i>134</i>

WELL LOCATION:
 sec *28* T *2* N R *11* E
31+ miles *E* of *Wiggins*
 (distance) (direction) (nearest town)

WELL PURPOSE: *Home*
 (home, irrigation, municipal, industrial)

- WELL COMPLETION DATA:
- (1) diameter (inches) *2"*
 - (2) total depth (feet) *134'*
 - (3) static water level (feet) *50'* below top of ground.
 - (4) casing *Pvc*, *129'*
 (material) (depth)
 (size) if telescope see back.
 - (5) screen *5'*, *129'*
 (length) (depth to top)
2", *Pvc*
 (size) (material)
 - (6) pump *1* *8*
 (HP) (yield gpm)
Electric
 (type power)
 - (7) electric log *NO*
 (yes or no)
 (organization running log)
 - (8) how well bottom plugged *Capped*

DRILLERS REMARKS:


DEPT. OF NATURAL RESOURCES
 BUREAU OF LAND & WATER RESOURCES

OCT 2 1981

RECEIVED

If well telescopes please sketch and show depths.

GROUND LEVEL

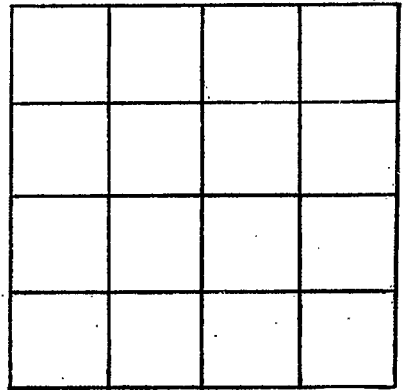

SECTION _____

Please indicate well location X.

ADDITIONAL INFORMATION

If more than one screen,
show locations of each on sketch.