

MISSISSIPPI DEPARTMENT OF ENVIRONMENTAL QUALITY

Office of Land and Water Resources

P. O. Box 10631
Jackson, MS 39289-0631
WATER WELL DRILLERS LOG

COUNTY WELL LOCATED <u>Stone</u>	
WELL NUMBER <u>C 2115</u>	CODED
DATE WELL COMPLETED <u>8-10-95</u>	

PERMIT NUMBER
NAME OF DRILLING FIRM <u>Boone's Water Well</u>

NAME & MAILING ADDRESS OF LANDOWNER <u>Ed Bremner</u>		
<u>2922 Hwy 26</u>		
<u>Wiggins Ms.</u>		
WELL LOCATION: SEC	TOWNSHIP	RANGE
<u>28</u>	<u>2</u>	<u>11</u>
DISTANCE _____ Miles _____ of _____		
DIRECTION _____ NEAREST TOWN _____		
OTHER LANDMARK		
WELL PURPOSE: <input checked="" type="checkbox"/> Home Irrigation, <input type="checkbox"/> Municipal, <input type="checkbox"/> Industrial, <input type="checkbox"/> Fish Pond, etc.		

PUMP DATA		
PUMP TYPE (Circle One): <input checked="" type="checkbox"/> Submersible, <input type="checkbox"/> Turbine, <input type="checkbox"/> Jet, <input type="checkbox"/> Flowing Well, Other (Describe) _____		
POWER TYPE (Circle One): <input checked="" type="checkbox"/> Electric, <input type="checkbox"/> Tractor, <input type="checkbox"/> Diesel, <input type="checkbox"/> Gasoline, <input type="checkbox"/> Butane, Other (Describe) _____		
Pump Capacity (GPM)	No. of Stages	Setting Depth _____ FT.
PUMP TEST		
Well yielded _____ GPM with a drawdown of _____ ft. after _____ hours of pumping		

WELL DATA		
Well Depth <u>90</u>	Casing Diameter (In.) <u>4</u>	Casing Length (Ft.) <u>70</u>
Type of Casing <u>pch40</u>	Hole Depth <u>90</u>	Depth to Static Water Level <u>40</u>

LOG DATA	
TYPE OF LOG RUN (Circle One): <input checked="" type="checkbox"/> No Log Run, <input type="checkbox"/> Electric, <input type="checkbox"/> Gamma Ray, <input type="checkbox"/> Density, <input type="checkbox"/> Sonic, <input type="checkbox"/> Neutron, Other (Describe) _____	
Name of Organization Running Log	

TYPE OF COMPLETION: (Circle One or More):
 Gravel Packed, Underreamed, Telescoped,
 Natural Development, Open Hole, Other _____
(Describe) _____

WELL GROUTED TO A DEPTH OF 6 FEET
Type Grout (circle one): Cement, Bentonite, or Mix

GEOLOGIC DATA (Office Use Only)			
Surface Elev.	Geologic Unit	Unit Thickness	Depth to Top
Subs. SWL	Date	Analysis	Aquifer Test
Driller's Remarks			
Top of Lap Pipe or Reduction in Casing			
FEET		IF TELESCOPED OR MORE THAN ONE SCREEN: USE BACK PAGE	


SCREEN DATA		
Diameter - Inches <u>4</u>	Length - Feet <u>20</u>	Slot Size - Inches <u>#8</u>
Screen Type <u>Sch40</u>		Depth to Bottom - Feet

DESCRIPTION OF FORMATIONS ENCOUNTERED	FROM	TO
<u>Clay</u>	<u>0</u>	<u>20</u>
<u>Sand</u>	<u>20</u>	<u>90</u>

FORMATIONS (Continued)	FROM	TO
JAN 29 1996		
Dept. of Environmental Quality Office of Land & Water Resources		
IF MORE SPACE IS NEEDED, USE BACK		

If well telescopes please
sketch and show depths.

GROUND LEVEL

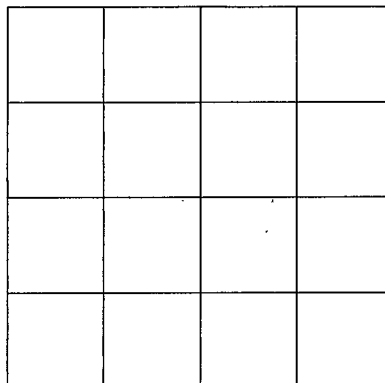

SECTION _____

Please indicate well location X.

ADDITIONAL INFORMATION

If more than one screen,
show location of each on sketch.
