

**MISSISSIPPI DEPARTMENT OF ENVIRONMENTAL QUALITY**  
**Office of Land and Water Resources**

P. O. Box 10631  
 Jackson, MS 39289-0631  
**WATER WELL DRILLERS LOG**

COUNTY WELL LOCATED <b>Stone</b>	
WELL NUMBER <b>C-2137</b>	CODED
DATE WELL COMPLETED <b>5-5-2000</b>	

PERMIT NUMBER
NAME OF DRILLING FIRM <b>Brown's Water Well</b>

NAME & MAILING ADDRESS OF LANDOWNER <b>Fred Middleton</b>			
<b>Hwy 26</b>			
<b>Wiggins, MS 39577</b>			
WELL LOCATION.	SEC	TOWNSHIP	RANGE
	<b>26</b>	<b>2 N</b>	<b>11 E</b>
DISTANCE	DIRECTION	NEAREST TOWN	
<b>4</b> Miles	<b>E</b>	of <b>Wiggins</b>	
OTHER LANDMARK			
WELL PURPOSE: <input checked="" type="checkbox"/> Home Irrigation, <input type="checkbox"/> Municipal, <input type="checkbox"/> Industrial, <input type="checkbox"/> Fish Pond, etc.			

<b>PUMP DATA</b>		
PUMP TYPE (Circle One): Submersible, Turbine, <input checked="" type="radio"/> Jet, Flowing Well, Other (Describe) _____		
POWER TYPE (Circle One): <input checked="" type="radio"/> Electric, Tractor, Diesel, Gasoline, Butane, Other (Describe) _____ H/P <b>1</b>		
Pump Capacity (GPM) <b>5</b>	No. of Stages <b>2</b>	Setting Depth <b>FT.</b>
PUMP TEST		
Well yielded _____ GPM with a drawdown of _____ ft. after _____ hours of pumping		

<b>WELL DATA</b>		
Well Depth <b>80</b>	Casing Diameter (In.) <b>2</b>	Casing Length (Ft.) <b>70</b>
Type of Casing <b>Sch 40</b>	Hole Depth <b>80</b>	Depth to Static Water Level <b>40</b>
TYPE OF COMPLETION: (Circle One or More): <input checked="" type="checkbox"/> Gravel Packed, <input type="checkbox"/> Underreamed, <input type="checkbox"/> Telescoped, <input type="checkbox"/> Natural Development, <input type="checkbox"/> Open Hole, <input type="checkbox"/> Other (Describe) _____		

<b>LOG DATA</b>	
TYPE OF LOG RUN (Circle One): No Log Run, Electric, Gamma Ray, Density, Sonic, Neutron, Other (Describe) _____	
Name of Organization Running Log	

WELL GROUTED TO A DEPTH OF <b>10</b> FEET Type Grout (circle one): <input checked="" type="radio"/> Cement, <input type="radio"/> Bentonite, or Mix
--

<b>GEOLOGIC DATA (Office Use Only)</b>			
Surface Elev.	Geologic Unit	Unit Thickness	Depth to Top
Subs. SWL	Date	Analysis	Aquifer Test

<b>SCREEN DATA</b>		
Diameter - Inches <b>2</b>	Length - Feet <b>10</b>	Slot Size - Inches <b>#8</b>
Screen Type <b>Sch 40</b>	Depth to Bottom - Feet	

Driller's Remarks
Top of Lap Pipe or Reduction in Casing <b>10</b> FEET IF TELESCOPED OR MORE THAN ONE SCREEN, USE BACK PAGE

DESCRIPTION OF FORMATIONS ENCOUNTERED	FROM	TO
<b>Clay</b>	<b>0</b>	<b>20</b>
<b>Sand</b>	<b>20</b>	<b>80</b>


FORMATIONS (Continued)	FROM	TO
<b>SEP 07 2000</b>		

**Dept. of Environmental Quality**  
**Office of Land & Water Resources**

IF MORE SPACE IS NEEDED, USE BACK

If well telescopes please  
sketch and show depths.

GROUND LEVEL

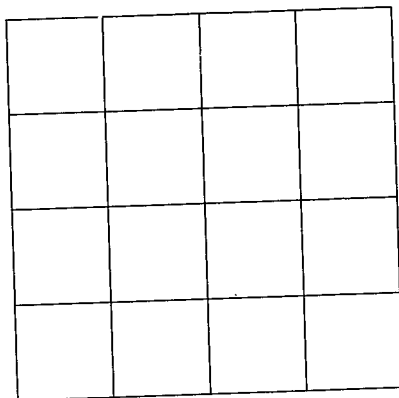

SECTION \_\_\_\_\_

Please indicate well location X.

ADDITIONAL INFORMATION

If more than one screen,  
show location of each on sketch.