

STONE MISSISSIPPI BOARD OF WATER COMMISSIONERS

E D I

12-31-64

WATER WELL DRILLERS LOG

Date: 12-31, 1964, Driller: Sutton Well Works County Stone

(Name)

(1) Owner of Land: Jon. Campbell Co.
(Name)

Wiggins Miss.
(Address)

(2) Location: SW 1/4, NE 1/4; Sec 19 T26 R 10 W

6 miles E of Wiggins
(distance) (direction) (Nearest Town)

(3) Topography: Hilly
(Hilly) (Flat) (Level)

(4) Purpose of Well: Irrigation
(Domestic Irrigation, Municipal, Industrial, Other)

Description & Color of Materials
Sand, Clay, Red Clay, Shell, etc.

Thick-
ness
Feet

Depth
Feet

| | | |
|----------------------------|------------|------------|
| <u>red sand + clay</u> | <u>22</u> | <u>22</u> |
| <u>red sand + mud</u> | <u>65</u> | <u>87</u> |
| <u>Clay - sand</u> | <u>76</u> | <u>163</u> |
| <u>blue clay</u> | <u>157</u> | <u>320</u> |
| <u>sand</u> | <u>23</u> | <u>343</u> |
| <u>Sandy clay</u> | <u>111</u> | <u>454</u> |
| <u>Clay - sand streaks</u> | <u>176</u> | <u>630</u> |
| <u>fine sand</u> | <u>42</u> | <u>672</u> |
| <u>sand</u> | <u>18</u> | <u>690</u> |
| <u>gravel + sand</u> | <u>44</u> | <u>734</u> |

Information upon completion of well:

(1) Diameter 6x8 inches.

(2) Total Depth 734 feet.

(3) Water Level 152 feet below top of ground.

(4) Cased to all ^{top 30' - 8"}, Size 6" _{dia.}

(5) Screen: Size 6", Length 40.

(6) Were any formations sealed against pollution?


yes, no.

If YES depth of formation surface

Why _____

Drillers Remarks: _____

E-log #42

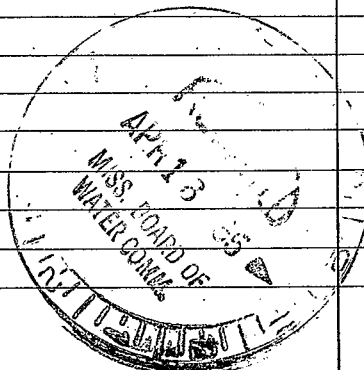

(Use Back Side)

Well No.

