

4/ STONE MISSISSIPPI BOARD OF WATER COMMISSIONERS

~~EDZ~~

11-23-64 WATER WELL DRILLERS LOG

Date: ~~12-31~~ <sup>11-23</sup>, 1964, Driller: Little Well Works County Stone  
(Name)

(1) Owner of Land: Jas. Campbell Co.  
(Name)  
Wiggins, Miss.  
(Address)

(2) Location: SW 1/4, SE 1/4, NE 1/4, Sec. 26, T25R 10  
19  
10  
10  
6 miles E of Wiggins,  
(distance) (direction) (Nearest Town)

(3) Topography: hilly  
(Hilly) (Flat) (Level)

(4) Purpose of Well: Irrigation  
(Domestic Irrigation  
Municipal, Industrial, Other)

Description & Color of Materials Sand, Clay, Red Clay, Shell, etc.	Thick- ness Feet	Depth Feet
<u>Clay</u>	<u>235</u>	<u>235</u>
<u>Sand streaks</u>	<u>26</u>	<u>261</u>
<u>Sand</u>	<u>8</u>	<u>269</u>
<u>Clay</u>	<u>118</u>	<u>387</u>
<u>Sand</u>	<u>8</u>	<u>395</u>
<u>Clay</u>	<u>65</u>	<u>460</u>
<u>Sand</u>	<u>9</u>	<u>469</u>
<u>Clay</u>	<u>32</u>	<u>501</u>
<u>Clay - sand streaks</u>	<u>195</u>	<u>696</u>
<u>sand</u>	<u>45</u>	<u>741</u>

Information upon completion of well:

(1) Diameter 6x4 inches.

(2) Total Depth 741 feet.

(3) Water Level 158 feet below top of ground.

(4) Cased to all, Size Top 332'-6"  
4"

(5) Screen: Size 4", Length 20'

(6) Were any formations sealed against pollution?  
yes,  no.


If YES depth of formation \_\_\_\_\_

Why \_\_\_\_\_

Drillers Remarks: \_\_\_\_\_

\_\_\_\_\_

\_\_\_\_\_

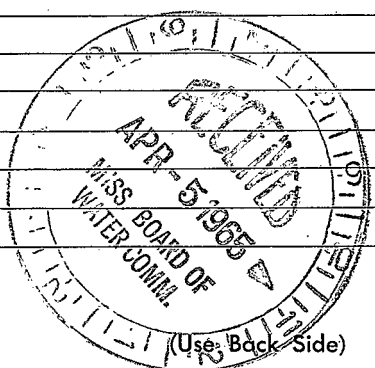

1. The first part of the document discusses the importance of maintaining accurate records of all transactions. It emphasizes that this is crucial for the company's financial health and for providing a clear picture of its operations to stakeholders.

2. The second part of the document outlines the various methods used to collect and analyze data. It includes a detailed description of the data collection process, from identifying the sources of data to the actual collection and storage of the data.

3. The third part of the document describes the various methods used to analyze the data. It includes a detailed description of the data analysis process, from identifying the key variables to the actual analysis and interpretation of the results.

4. The fourth part of the document discusses the various methods used to present the data. It includes a detailed description of the data presentation process, from identifying the key findings to the actual presentation of the data in a clear and concise manner.

5. The fifth part of the document discusses the various methods used to ensure the accuracy and reliability of the data. It includes a detailed description of the data quality control process, from identifying the potential sources of error to the actual implementation of the quality control measures.