

location doubtful.

CODED

MISSISSIPPI
BOARD OF WATER COMMISSIONERS
416 North State Street
Jackson, Mississippi 39201

WATER WELL DRILLERS LOG

STONE
D 9
3-68

3-18 1968
date well completed

Low Smith
firm name

Stone
county well located

LANDOWNER: H.C. Cain

description of formations encountered

from to

Wiggins Miss. 39577

Top Soil
Clay
Sand
Clay

0 9
2 92
99 71
71

(mailing address)

WELL LOCATION:

10^W miles S.E. of Wiggins
sec. 15 T 2^S N R 9^W E
S W
(distance) (direction) (nearest town)

WELL PURPOSE:

(home, irrigation, municipal, industrial)

WELL COMPLETION DATA:

- (1) diameter (inches) 2
- (2) total depth (feet) 70
- (3) static water level (feet) 45' below top of ground.
- (4) casing Plastic 65' (material) (depth)

If telescope see back. (size)

- (5) screen 5' 65' (length) (depth to top)

(size) (material)

- (6) pump 1 8 (HP) (yield gpm)

Electric (type power)

- (7) electric log no (yes or no)

(organization running log)


- (8) how well bottom plugged Bechubul

DRILLERS REMARKS:

JUN - 7 1968
MISS. BOARD OF
WATER COMMISSIONERS

If well telescopes please
sketch and show depths.

GROUND LEVEL

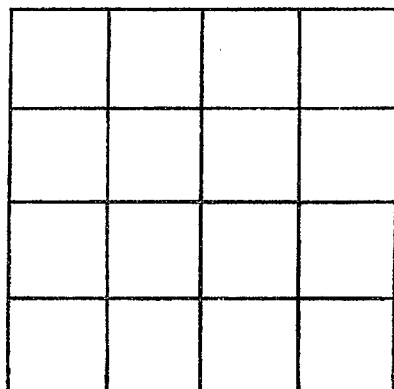

SECTION _____

Please indicate well location X.

ADDITIONAL INFORMATION

If more than one screen,
show locations of each on sketch.