

MISSISSIPPI  
BOARD OF WATER COMMISSIONERS  
416 North State Street  
Jackson, Mississippi 39201

CODED

WATER WELL DRILLERS LOG

STONE
D 13
5-68

5-19 1968 l w Smith Stone  
 date well completed firm name county well located

LANDOWNER M F Creel  
Wiggins Miss  
R. 1  
 (mailing address)

description of formations encountered	from	to
<u>Sand</u>	<u>0</u>	<u>2</u>
<u>hard clay</u>	<u>2</u>	<u>20</u>
<u>hard clay</u>	<u>20</u>	<u>50</u>

WELL LOCATION:  
 sec 31 T 2 N R 10  
7 miles S.E of Wiggins  
 (distance) (direction) (nearest town)

WELL PURPOSE:  
 (home, irrigation, municipal, industrial)

WELL COMPLETION DATA:

(1) diameter (inches) 2

(2) total depth (feet) 50

(3) static water level (feet) 30 below above top of ground.

(4) casing Plastic  
 (material) (depth)

\_\_\_\_\_ if telescope see back.  
 (size)

(5) screen 5' 45'  
 (length) (depth to top)

1/8 Plastic  
 (size) (material)

(6) pump 1 12  
 (HP) (yield gpm)

Electric  
 (type power)

(7) electric log \_\_\_\_\_  
 (yes or no)

\_\_\_\_\_ (organization running log)


(8) how well bottom plugged \_\_\_\_\_

DRILLERS REMARKS:

JUN - 7 1968  
 MISS. BOARD OF  
 WATER COM.

If well telescopes please sketch and show depths.

GROUND LEVEL

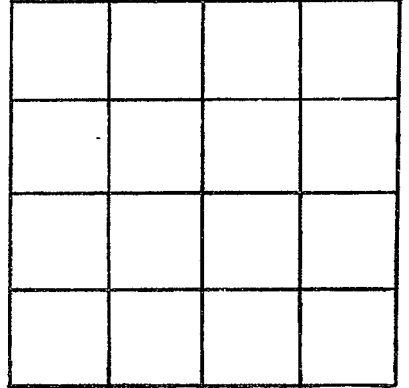

SECTION \_\_\_\_\_

Please indicate well location X.

ADDITIONAL INFORMATION

If more than one screen,  
show locations of each on sketch.