

CODED

MISSISSIPPI
BOARD OF WATER COMMISSIONERS
416 North State Street
Jackson, Mississippi 39201

WATER WELL DRILLERS LOG

STONE
D 14
7-68

7-30 1968 Parneel Anderson Stone
date well completed firm name county well located

LANDOWNER: Leon Fairley
Route

description of formations encountered	from	to
<u>Top Soil</u>	<u>0</u>	<u>3</u>
<u>Clay</u>	<u>3</u>	<u>12</u>
<u>Coarse Sand + Gravel</u>	<u>12</u>	<u>37</u>
<u>Blue clay</u>	<u>37</u>	<u>170</u>
<u>Fine Sand</u>	<u>170</u>	<u>185</u>
<u>Blue clay</u>	<u>185</u>	<u>250</u>
<u>Fine Sand</u>	<u>250</u>	<u>264</u>
<u>Blue clay</u>	<u>264</u>	<u>320</u>
<u>Fine Sand</u>	<u>320</u>	<u>380</u>
<u>Coarse Sand</u>	<u>380</u>	<u>390</u>
<u>Coarse Sand + Gravel</u>	<u>390</u>	<u>403</u>

Wiggins Miss
(mailing address)


WELL LOCATION:
sec. 20 T. 2 N. R. 9 E.
S W
14 miles E of Wiggins
(distance) (direction) (nearest town)

WELL PURPOSE: Home
(home, irrigation, municipal, industrial)

WELL COMPLETION DATA:


- (1) diameter (inches) 2
- (2) total depth (feet) 403
- (3) static water level (feet) 6 below above top of ground.
- (4) casing Galvanize 493
(material) (depth)
3 if telescope see back.
(size)
- (5) screen 10, 493
(length) (depth to top)
2", Stainless Steel
(size) (material)
- (6) pump _____
(HP) (yield gpm)
(type power)
- (7) electric log no
(yes or no)
(organization running log)
- (8) how well bottom plugged
Backwash valve

DRILLERS REMARKS:

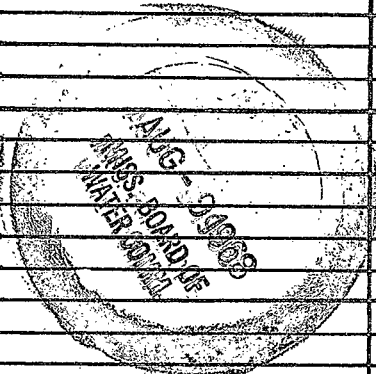

If well telescopes please sketch and show depths.

GROUND LEVEL

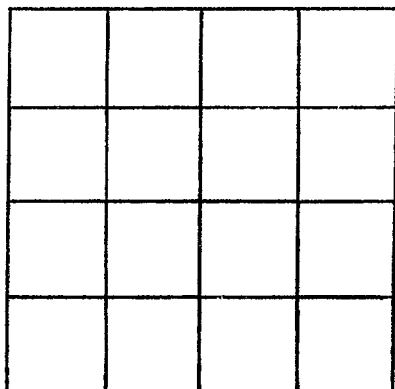

SECTION 20

Please indicate well location X.

ADDITIONAL INFORMATION

If more than one screen, show locations of each on sketch.