

Stone
D18
11-8-68

MISSISSIPPI
BOARD OF WATER COMMISSIONERS CODED
416 North State Street
Jackson, Mississippi 39201

CODED

WATER WELL DRILLERS LOG

11-8 1968 Parwell Anderson Stone
date well completed firm name county well located

LANDOWNER: Everett Compston

description of formations encountered	from	to
TOP Soil	0	4
Red Clay	4	30
Fine Sand	30	53
Red Clay	53	66
fine sand	66	71
Coarse Sand	71	81

Route 1
Wiggins Miss
(mailing address)

WELL LOCATION:
sec 2 T 2 N R 10 W S
15 miles E of Wiggins
(distance) (direction) (nearest town)

WELL PURPOSE: Home
(home, irrigation, municipal, industrial)

- WELL COMPLETION DATA:
- (1) diameter (inches) 2"
 - (2) total depth (feet) 81
 - (3) static water level (feet) 50 below top of ground.
 - (4) casing Plastic, 75 (material), (depth)
 - (size) If telescope see back.
 - (5) screen 6, 75 (length), (depth to top)
 - 5" Plastic (size), (material)
 - (6) pump 1, 9 (HP), (yield gpm)
 - Electric (type power)
 - (7) electric log (yes or no)
 - (organization running log)
 - (8) how well bottom plugged Backwash Valve


CODED

FEB - 7 1968
MISS. Bd. OF WATER COMMISSIONERS

DRILLERS REMARKS:

If well telescopes please sketch and show depths.

GROUND LEVEL

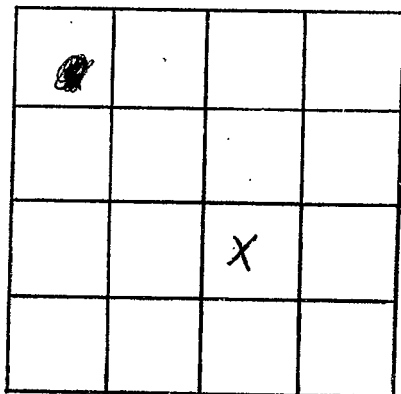

SECTION 9

Please indicate well location X.

ADDITIONAL INFORMATION

If more than one screen,
show locations of each on sketch.