

CODED

MISSISSIPPI
BOARD OF WATER COMMISSIONERS
416 North State Street
Jackson, Mississippi 39201

CODED

WATER WELL DRILLERS LOG

STONE
D 19
5-8-68

5-8 1968
date well completed

L. W. Smith
firm name

Stone
county well located

LANDOWNER:

C. J. Breland
Wiggins P.O.
(mailing address)

description of formations
encountered

Topsoil
Clay
Sand

from	to
0	2
2	18
18	50

WELL LOCATION:

sec. 7 T 2 S R 10 W
6 miles E of Wiggins
(distance) (direction) (nearest town)

WELL PURPOSE:

(home, irrigation, municipal, industrial)

WELL COMPLETION DATA:

- (1) diameter (inches) 2
- (2) total depth (feet) 50
- (3) static water level (feet) 22 below above top of ground.
- (4) casing Plastic 50 (material) (depth)
 if telescope see back.
(size)
- (5) screen 5 45 (length) (depth to top)
 (size) (material)
- (6) pump 1 14 (HP) (yield gpm)
Electric (type power)
- (7) electric log (yes or no)
 (organization running log)

(8) how well bottom plugged Broken

DRILLERS REMARKS:


CODED

FEB - 1 1968

MISS. Bd. OF
WATER COMML.

If well telescopes please sketch and show depths.

GROUND LEVEL

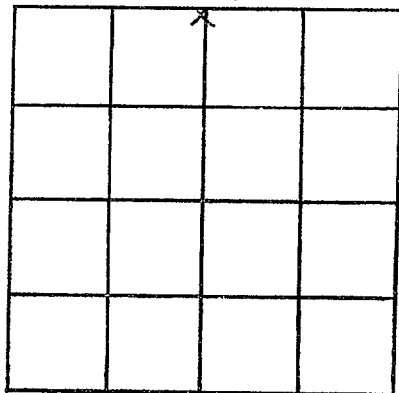

SECTION _____

Please indicate well location X.

ADDITIONAL INFORMATION

If more than one screen,
show locations of each on sketch.