

STONE  
D 20  
5-30-68

MISSISSIPPI  
BOARD OF WATER COMMISSIONERS  
416 North State Street  
Jackson, Mississippi 39201

CODED

CODED

WATER WELL DRILLERS LOG

5-30 1968 date well completed  
L W Smith firm name  
STONE county well located

LANDOWNER:  
Gavin Moore  
(mailing address)

description of formations encountered	from	to
	Top Soil	0
Clay	1	8
Sand & Gravel	8	90

WELL LOCATION:  
sec. 23 T 7 S R 10 W  
12 miles E of Wiggins  
(distance) (direction) (nearest town)

WELL PURPOSE:  
(home, irrigation, municipal, industrial)

WELL COMPLETION DATA:

(1) diameter (inches) 2

(2) total depth (feet) 30

(3) static water level (feet) 18 below top of ground.

(4) casing Plastic (material), (depth),  
if telescope see back.  
(size)

(5) screen 5 (length), 25 (depth to top)  
(size), (material)

(6) pump 1 (HP), 14 (yield gpm)  
Electric (type power)

(7) electric log (yes or no)  
(organization running log)

(8) how well bottom plugged Backed

CODED


FEB 4 1968

MISS. BD. OF WATER COMM.

DRILLERS REMARKS:

If well telescopes please sketch and show depths.

GROUND LEVEL

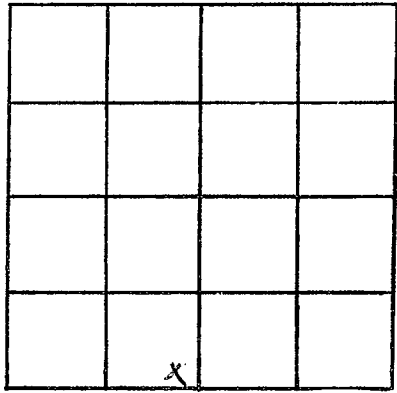

SECTION \_\_\_\_\_

Please indicate well location X.

ADDITIONAL INFORMATION

If more than one screen, show locations of each on sketch.