

Stone
D 21
3-18-68

MISSISSIPPI
BOARD OF WATER COMMISSIONERS
416 North State Street
Jackson, Mississippi 39201

WATER WELL DRILLERS LOG

CODED

3-18 1968 L W Smith Stone
date well completed firm name county well located

LANDOWNER: H.C. Cain
Wiggins
(mailing address)

description of formations encountered

from to

| | | |
|---------------|----|----|
| Top Soil | 0 | 1 |
| Clay | 1 | 12 |
| Sand | 12 | 18 |
| Clay | 18 | 52 |
| Sand & gravel | 52 | 70 |
| Clay | | |

WELL LOCATION:
sec. 9 T 2 S R 10 W
12 miles S.E. of Wiggins
(distance) (direction) (nearest town)

WELL PURPOSE:
(home, irrigation, municipal, industrial)

WELL COMPLETION DATA:


(1) diameter (inches) 2"
(2) total depth (feet) 70
(3) static water level (feet) 52 below top of ground.
(4) casing Plastic, 70'
(material) (depth)

CODED

_____ If telescope see back.
(size)
(5) screen 5' 65'
(length) (depth to top)
2" Plastic
(size) (material)

(6) pump 1 12
(HP) (yield gpm)
Electric
(type power)

(7) electric log _____
(yes or no)

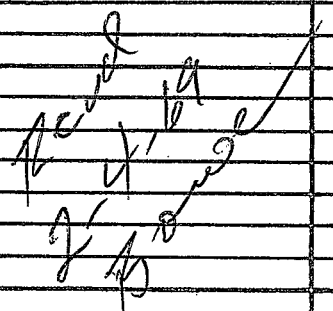

_____ (organization running log)

(8) how well bottom plugged Back W

DRILLERS REMARKS:

If well telescopes please sketch and show depths.

GROUND LEVEL

| | | | |
|--|--|--|---|
| | | | |
| | | | |
| | | | |
| | | | X |

SECTION 9

Please indicate well location X.

ADDITIONAL INFORMATION

If more than one screen, show locations of each on sketch.