

Stone
D 22
2-1-69

MISSISSIPPI
BOARD OF WATER COMMISSIONERS
416 North State Street
Jackson, Mississippi 39201

WATER WELL DRILLERS LOG

2-1-69 date well completed
Law Smith firm name
Stone county well located

LANDOWNER:	description of formations encountered	from	to
Laurie Gravel	Top Soil	0	2
Wiggins Route (mailing address)	Clay Sand	2 30	30 58
WELL LOCATION: sec. 21 T. 2 S. R. 10 W. 10 miles E of Wiggins (distance) (direction) (nearest town)			
WELL PURPOSE: (home, irrigation, municipal, industrial)			
WELL COMPLETION DATA:			
(1) diameter (inches) 2"			
(2) total depth (feet) 58'			
(3) static water level (feet) 30" below top of ground.			
(4) casing Plastic 58' (material) (depth)			
_____ If telescope see back. (size)			
(5) screen 5' 5.5' (length) (depth to top)			
2" Plastic (size) (material)			
(6) pump 1 12 (HP) (yield gpm)			
Electric (type power)			
(7) electric log _____ (yes or no)			
_____ (organization running log)			
(8) how well bottom plugged Backward			
DRILLERS REMARKS:			


COPIED

FEB 25 1969

MISS. BD. OF
WATER COMMISSIONERS

If well telescopes please sketch and show depths.

GROUND LEVEL

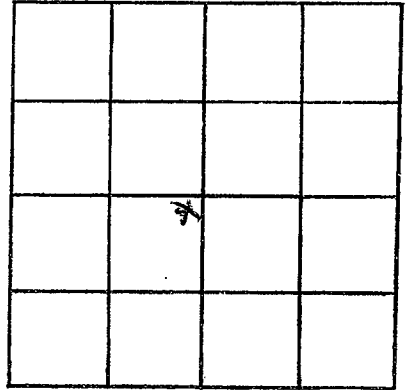

SECTION 21

Please indicate well location X.

ADDITIONAL INFORMATION

If more than one screen, show locations of each on sketch.