

STONE
D25
3-5-74

MISSISSIPPI
BOARD OF WATER COMMISSIONERS
416 North State Street
Jackson, Mississippi 39201

CODED

WATER WELL DRILLERS LOG

3-5-74 date well completed
Pannell Anderson firm name
Stone county well located

LANDOWNER:
William Starches

(mailing address)

description of formations encountered	from	to
<i>Top Soil</i>	<i>0</i>	<i>4</i>
<i>Pink Clay</i>	<i>4</i>	<i>16</i>
<i>Fine Sand</i>	<i>16</i>	<i>30</i>
<i>Course Sand</i>	<i>30</i>	<i>45</i>

WELL LOCATION:
sec. *88* T. *8* S. R. *10* W.
8 miles *W* of *Wiggins*
(distance) (direction) (nearest town)


WELL PURPOSE: *HOME*
(home, irrigation, municipal, industrial)

- WELL COMPLETION DATA:
- (1) diameter (inches) *2"*
 - (2) total depth (feet) *45'*
 - (3) static water level (feet) *32'* below top of ground
 - (4) casing *Plastic* *40'*
(material) (depth)

____ if telescope see back.
(size)
 - (5) screen *5'* *40'*
(length) (depth to top)
2" *Plastic*
(size) (material)
 - (6) pump *1* *10*
(HP) (yield gpm)
Elect
(type power)
 - (7) electric log *no*
(yes or no)

(organization running log)
 - (8) how well bottom plugged *Bottom valve*

CODED

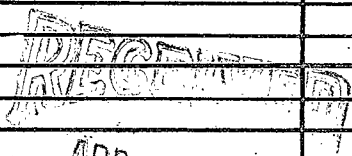

APR 11 1974

MISS. BD. OF

DRILLERS REMARKS:

