

STONE
D28
11-12-74

MISSISSIPPI
BOARD OF WATER COMMISSIONERS
416 North State Street
Jackson, Mississippi 39201

WATER WELL DRILLERS LOG

CODED

11-12 date well completed 1974 firm name Stone county well located

LANDOWNER:
Lona Fairley
(mailing address)

description of formations encountered	from	to
Top Soil	0	4
Red Clay	4	38
Coarse Sand	38	59

WELL LOCATION:
sec. 5 T. 2 R. 10 S. W.
10 miles NE of Tula
(distance) (direction) (nearest town)

WELL PURPOSE: HOME
(home, irrigation, municipal, industrial)

- WELL COMPLETION DATA:
- (1) diameter (inches) 8"
 - (2) total depth (feet) 59'
 - (3) static water level (feet) 48' below top of ground
 - (4) casing Plastic 54' (material) (depth)
if telescope see back. (size)
 - (5) screen 5" 54' (length) (depth to top)
2" Plastic (size) (material)
 - (6) pump 1 (HP) 9 (yield gpm)
E-Val (type power)
 - (7) electric log no (yes or no)

CODED


RECEIVED
DEC 6 1974

(organization running log)
(8) how well bottom plugged
Plugged

DRILLERS REMARKS:

If well telescopes please sketch and show depths.

GROUND LEVEL

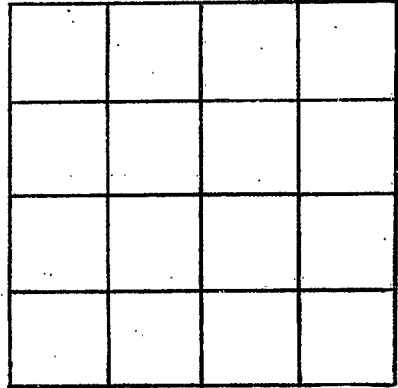

SECTION _____

Please indicate well location X.

ADDITIONAL INFORMATION

If more than one screen, show locations of each on sketch.