

STONE
D29
1-2-75

MISSISSIPPI
BOARD OF WATER COMMISSIONERS
416 North State Street
Jackson, Mississippi 39201

CODED

WATER WELL DRILLERS LOG

1-2 date well completed
75 Parnice Anderson firm name
Stone county well located

LANDOWNER:
Doll Breland
(mailing address)

description of formations encountered	from	to
Top Soil	0	4
Red Clay	4	18
Fine Sand	18	22
Coarse Sand	22	38

WELL LOCATION:
sec. 28 T. 2 R. 10 E
9 miles E of Wiggins
(distance) (direction) (nearest town)

WELL PURPOSE: HOME
(home, irrigation, municipal, industrial)

- WELL COMPLETION DATA:
- (1) diameter (inches) 2"
 - (2) total depth (feet) 38'
 - (3) static water level (feet) 14' below top of ground
 - (4) casing Plastic 33' (material) (depth)
 - (5) screen 5' 33' (length) (depth to top)
2" Plastic (size) (material)
 - (6) pump 1 (HP) 10 (yield gpm)
Elect (type power)
 - (7) electric log no (yes or no)
- (organization running log)

(8) how well bottom plugged
Plugged

DRILLERS REMARKS:


CODED

RECEIVED
FEB 5 1975

MISS. BD. OF WATER COMMISSIONERS

If well telescopes please sketch and show depths.

GROUND LEVEL

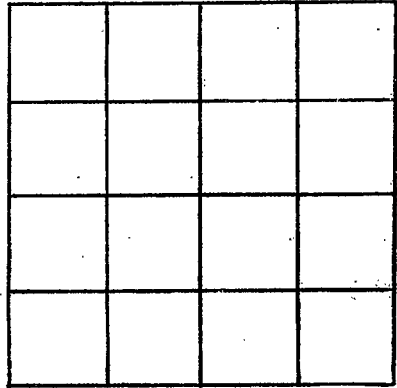

SECTION _____

Please indicate well location X.

ADDITIONAL INFORMATION

If more than one screen, show locations of each on sketch.