

STONE  
D-30  
1-21-80

MISSISSIPPI  
BOARD OF WATER COMMISSIONERS  
416 North State Street  
Jackson, Mississippi 39201

CODED

WATER WELL DRILLERS LOG

1-21-80 Griner Drilling Stone

date well completed

firm name

county well located

LANDOWNER:

Florida Gas Exploration  
1444 Capital Towers  
Jackson, MS 39201  
(mailing address)

description of formations encountered

from to

SAND	0	30
sand chalc	30	65'
SAND	65'	75'

WELL LOCATION:

2127' S + 1906' E

sec. 5 T. 2 N. R. 10 E NW/4

Wiggins  
(distance) (direction) (nearest town)

WELL PURPOSE: oil field supply  
(home, irrigation, municipal, industrial)

CODED

WELL COMPLETION DATA:

- (1) diameter (inches) 3"
- (2) total depth (feet) 756'
- (3) static water level (feet) 80' below top of ground.
- (4) casing steel 756' (material) (depth)  
3" (size) if telescope see back.
- (5) screen 42' 714' (length) (depth to top)  
3" perforated (size) (material)
- (6) pump 70 (HP) (yield gpm)  
AC (type power)
- (7) electric log (yes or no)

(organization running log)

(8) how well bottom plugged Orange Peel


DRILLERS REMARKS:

DEPT. OF NATURAL RESOURCES  
BUREAU OF LANDS & WATER RESOURCES

RECEIVED  
FEB 17 1980

If well telescopes please sketch and show depths.

GROUND LEVEL

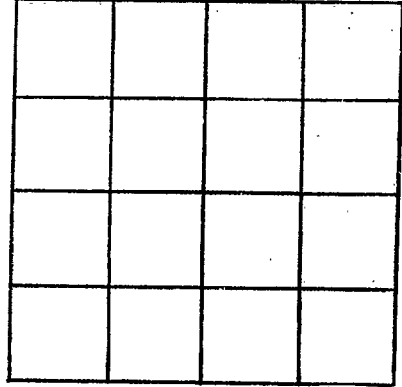

SECTION \_\_\_\_\_

Please indicate well location X.

ADDITIONAL INFORMATION

If more than one screen, show locations of each on sketch.