

STONE  
D 31  
12-8-80

MISSISSIPPI  
BOARD OF WATER COMMISSIONERS  
416 North State Street  
Jackson, Mississippi 39201

CODED

WATER WELL DRILLERS LOG

Shiner Drilling  
Service, Inc.

Stone Co.  
Wiggins

date well completed

firm name

county well located

LANDOWNER:

Getty Oil Corp.  
P.O. Box 16878  
Mobile, Ala. 36616  
(mailing address)

description of formations encountered

from to

streaked sand	0	105
chalk	105	210
streaked	210	273
chalk	273	315
streaked	315	525
chalk, streaked	525	567
sand	567	609

WELL LOCATION:

2468' 5" + 1122' 0"

Sec. 6 T. 2 N. R. 10 E. of

Wiggins (distance) (direction) (nearest town)

WELL PURPOSE: oil field supply

WELL COMPLETION DATA:

- (1) diameter (inches) 4"
- (2) total depth (feet) 609'
- (3) static water level (feet) 70' below top of ground.
- (4) casing Steel, 609' (material) (depth)  
4" If telescope see back. (size)
- (5) screen 42', 567' (length) (depth to top)  
4", perforated (size) (material)
- (6) pump 70 (HP) (yield gpm)  
AC (type power)
- (7) electric log (yes or no)

(organization running log)

(8) how well bottom plugged orange

DRILLERS REMARKS: peel


DEPT. OF NATURAL RESOURCES  
BUREAU OF LAND & WATER RESOURCES

DEC 24 1980

RECEIVED

If well telescopes please sketch and show depths.

GROUND LEVEL

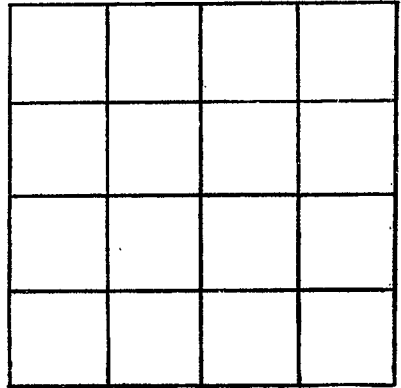

SECTION \_\_\_\_\_

Please indicate well location X.

ADDITIONAL INFORMATION

If more than one screen, show locations of each on sketch.