

MISSISSIPPI DEPARTMENT OF NATURAL RESOURCES

Bureau of Land and Water Resources

Southport Mall

P.O. Box 10631

Jackson, Mississippi 39209

CODED

WATER WELL DRILLERS LOG

Griner Drilling Service, Inc. Stone

STONE
D 32
12-19-80

date well completed

firm name

county well located

LANDOWNER:

Getty Oil Corporation
P.O. Box 16878
Mobile Ala 36616
(mailing address)

description of formations encountered

from

to

streaked

0

126

chalk

126

231

WELL LOCATION: *1600'54" x 1600'14"*

No 1
8 T 2 N R 10 E of
Black Creek Full sand
17 1/2 miles (distance) of (direction) (nearest town)

streaked

231

294

chalk

294

336

WELL PURPOSE: *oil field supply*
(home, irrigation, municipal, industrial)

chalk

336

357

WELL COMPLETION DATA:

(1) diameter (inches) *4"*

(2) total depth (feet) *357'*

(3) static water level (feet) *150' below*
top of ground.

(4) casing *steel, 336'*
(material) (depth)

4"
(size) if telescope see back.

(5) screen *42', 294'*
(length) (depth to top)

4", *perforated*
(size) (material)

(6) pump *75*
(HP) (yield gpm)

ac
(type power)

(7) electric log *—*
(yes or no)

(organization running log)

(8) how well bottom plugged *orange*

DRILLERS REMARKS:


DEPT. OF NATURAL RESOURCES
BUREAU OF LAND & WATER RESOURCES

JAN 19 1981

RECEIVED

If well telescopes please sketch and show depths.

GROUND LEVEL

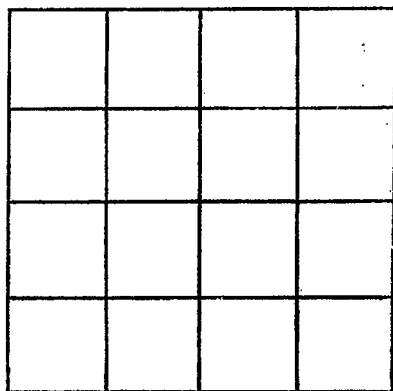

SECTION _____

Please indicate well location X.

ADDITIONAL INFORMATION

If more than one screen,
show locations of each on sketch.