

MISSISSIPPI DEPARTMENT OF NATURAL RESOURCES

Bureau of Land and Water Resources


Southport Mall

P.O. Box 10631

Jackson, Mississippi 39209

WATER WELL DRILLERS LOG

Grimes Drilling Service, Inc

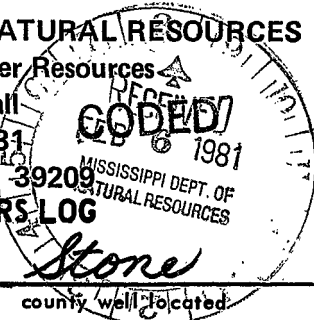

STONE
D 33
1-12-81

date well completed

firm name

county well located

LANDOWNER:

Florida Gas
1444 Capital Towers
Jackson, Ms
(mailing address)

description of formations encountered

from

to

streaked

0

126

chalk

126

231

streaked

231

294

sand

294

336

streaked chalk

336

600

sand

600

630

WELL LOCATION: *2537'N & 2081'E*

sec. *4* T. *2* N. R. *10* E of

Wigan's
Black Creek Field

WELL PURPOSE: *oil field*


WELL COMPLETION DATA:

- (1) diameter (inches) *3"*
- (2) total depth (feet) *630'*
- (3) static water level (feet) *110'* (below/above top of ground)
- (4) casing *steel, 630'*
(material) (depth)
3"
(size) if telescope see back.
- (5) screen *42', 588'*
(length) (depth to top)
3", perforated
(size) (material)
- (6) pump *—* *70*
(HP) (yield gpm)
ac
(type power)
- (7) electric log *—*
(yes or no)
—
(organization running log)
- (8) how well bottom plugged *orange*
peel

DRILLERS REMARKS:

If well telescopes please
sketch and show depths.

GROUND LEVEL

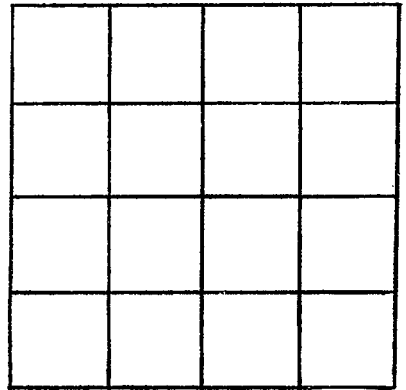

SECTION _____

Please indicate well location X.

ADDITIONAL INFORMATION

If more than one screen,
show locations of each on sketch.