

MISSISSIPPI DEPARTMENT OF NATURAL RESOURCES

Bureau of Land and Water Resources

Southport Mall

P.O. Box 10631

Jackson, Mississippi 39209

WATER WELL DRILLERS LOG

CODED

Stone
D 34
7-28-81

Griner Drilling Service, Inc.

Stone

7-28-81 date well completed

Griner Drilling Service, Inc. firm name

Stone county well located

LANDOWNER:

Getty Oil Corporation
P.O. Box 16809

description of formations encountered

from

to

sand, gravel

0 84

Mobile (mailing address) 36616

chalk

84 567

WELL LOCATION: 1600' S + 1500' W

sand

567 630

sec. 7 T. 2 N. R. 10 E. of
Black Creek Field
Energy Minerals

WELL PURPOSE: oil field supply

1600' S + 1500' W
OF NE COR OF SEC.

WELL COMPLETION DATA:


- (1) diameter (inches) 4"
- (2) total depth (feet) 630'
- (3) static water level (feet) 70' ^{below} top of ground.
- (4) casing steel, 630'
(material) (depth)
4"
(size) if telescope see back.
- (5) screen 42', 588'
(length) (depth to top)
4", perforated
(size) (material)
- (6) pump — TTD
(HP) (yield gpm)
AC
(type power)
- (7) electric log —
(yes or no)

CODED

(organization running log)


(8) how well bottom plugged orange
peel

DRILLERS REMARKS:

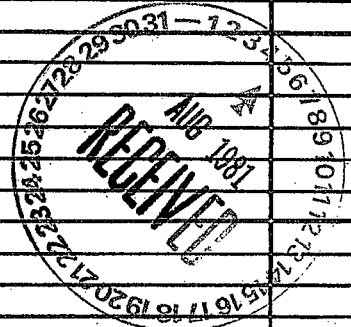

If well telescopes please sketch and show depths.

GROUND LEVEL

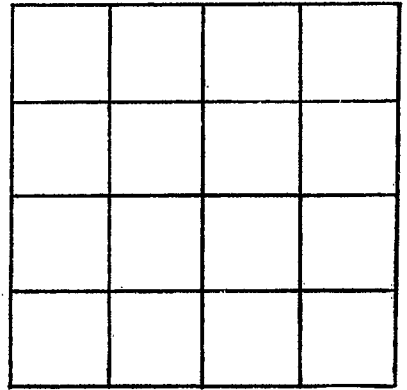

SECTION _____

Please indicate well location X.

ADDITIONAL INFORMATION

If more than one screen,
show locations of each on sketch.