

MISSISSIPPI DEPARTMENT OF NATURAL RESOURCES

Bureau of Land and Water Resources

Southport Mall

P.O. Box 10631

CODED

Jackson, Mississippi 39209

WATER WELL DRILLERS LOG

Stone
D35
10-6-81

10-6-81

Griner Drilling Service, Inc.

Stone

date well completed

firm name

county well located

LANDOWNER:

Getty Oil Corporation
P.O. Box 16809
Mobile, Alabama 36616
(mailing address)

description of formations encountered

from

to

clay & sand

0 252

sand

252 270

WELL LOCATION: 1500N+1500E of
sec. 9 T 2 N R 10 E SW/4

streaked sand & clay

270 465

No. 1 Black Creek Field
ENERGY
MINEFIELD
9-11
(distance) (direction) (nearest town)

sand

465 476

clay

476 550

sand

550 570

WELL COMPLETION DATA:

(1) diameter (inches)

4"

clay

570 631

(2) total depth (feet)

675'

CODED

sand

631 672

(3) static water level (feet) 140' below top of ground.

clay

672 675

(4) casing steel 672' (material) (depth)

4"

(size) if telescope see back.

(5) screen 42', 630' (length) (depth to top)

4"

(size) perforated (material)

CODED

(6) pump (HP)

100 (yield gpm)

AC (type power)

(7) electric log (yes or no)

(organization running log)

(8) how well bottom plugged orange


peel

DRILLERS REMARKS:

DEPT. OF NATURAL RESOURCES
BUREAU OF LAND & WATER RESOURCES
NOV 2 1981
RECEIVED

If well telescopes please sketch and show depths.

GROUND LEVEL

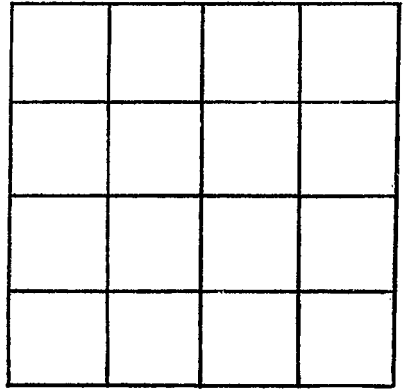

SECTION _____

Please indicate well location X.

ADDITIONAL INFORMATION

If more than one screen,
show locations of each on sketch.