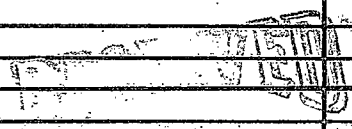


STONE
D 2000
2-5-76

MISSISSIPPI
BOARD OF WATER COMMISSIONERS
416 North State Street
Jackson, Mississippi 39201

WATER WELL DRILLERS LOG


2-5-76 date well completed
132 76 Parnell Anderson firm name
Stone county well located

LANDOWNER:	description of formations encountered	from	to
B. C. Miles (mailing address)	Top Soil	0	4
WELL LOCATION: sec 27 T 2 N R 10 E S W 10 miles E of Wiggins (distance) (direction) (nearest town)	Red clay	4	28
WELL PURPOSE: HOME (home, irrigation, municipal, industrial)	Fine Sand	28	49
WELL COMPLETION DATA: (1) diameter (inches) 3" (2) total depth (feet) 65 (3) static water level (feet) 21 below top of ground (4) casing Plastic, 60' (material) (depth) (size) If telescope see back. (5) screen 5' - 60' (length) (depth to top) 2" Plastic (size) (material) (6) pump 1 (HP) 10 (yield gpm) Elect (type power) (7) electric log no (yes or no) (organization running log)	Coarse Sand	49	65
(8) how well bottom plugged P. Anderson	 MAR 3 1976 MISS. BD. OF WATER COMMISSIONERS		

MISS. BD. OF WATER COMMISSIONERS

If well telescopes please sketch and show depths.

GROUND LEVEL

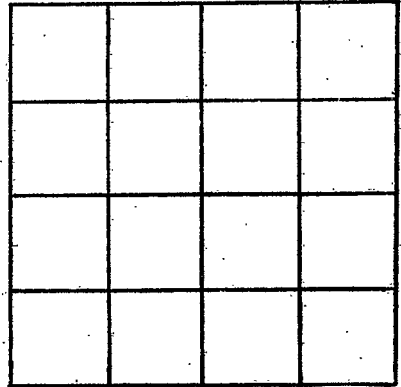

SECTION _____

Please indicate well location X.

ADDITIONAL INFORMATION

If more than one screen,
show locations of each on sketch.