

Stone  
D 2001  
11-16-76

MISSISSIPPI  
BOARD OF WATER COMMISSIONERS  
416 North State Street  
132 Jackson, Mississippi 39201

WATER WELL DRILLERS LOG

11-16 1976 date well completed  
Panell Anderson Stone firm name  
Stone county well located

LANDOWNER:  
J. J. Lames  
(mailing address)

WELL LOCATION:  
sec. 3 T 2 N R 10 E S W  
10 miles E of Wiggins  
(distance) (direction) (nearest town)

WELL PURPOSE: HOME  
(home, irrigation, municipal, industrial)

WELL COMPLETION DATA:

(1) diameter (inches) 2"  
(2) total depth (feet) 105'  
(3) static water level (feet) 25' below top of ground  
(4) casing Plastic 100'  
(material) (depth)  
(size) if telescope see back.  
(5) screen 5' 100'  
(length) (depth to top)  
2" Plastic  
(size) (material)  
(6) pump 1/2 6  
(HP) (yield gpm)  
Elect  
(type power)  
(7) electric log no  
(yes or no)  
(organization running log)

description of formations encountered	from	to
Top Soil	0	2
Clay	2	58
Thin Sand	58	61
Clay	61	83
Thin Sand	83	100
Coarse Sand	100	105


(8) how well bottom plugged  
Capped

DRILLERS REMARKS:

RECEIVED  
DEC 10 1976

If well telescopes please sketch and show depths.

GROUND LEVEL

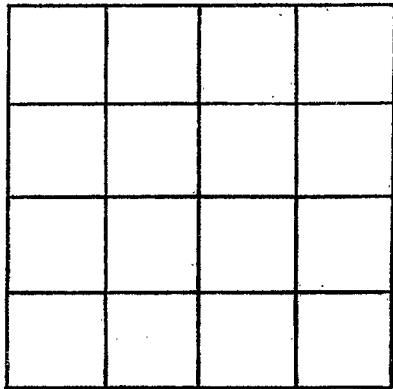

SECTION \_\_\_\_\_

Please indicate well location X.

ADDITIONAL INFORMATION

If more than one screen, show locations of each on sketch.