

Stone
D 2002
12/18/76

MISSISSIPPI
BOARD OF WATER COMMISSIONERS
416 North State Street
Jackson, Mississippi 39201

WATER WELL DRILLERS LOG

12-18 1976 Parnell Anderson Stone
date well completed firm name county well located

LANDOWNER:	description of formations encountered	from	to
<u>P. A. James</u> (mailing address)			
WELL LOCATION: sec. <u>7</u> T. <u>2</u> S. R. <u>10</u> W. <u>7</u> miles <u>NE</u> of <u>Wiggins</u> (distance) (direction) (nearest town)	<u>Hard Sand</u>	<u>3</u>	<u>64'</u>
WELL PURPOSE: <u>HOME</u> (home, irrigation, municipal, industrial)	<u>Course Sand</u>	<u>64</u>	<u>105'</u>
WELL COMPLETION DATA:			
(1) diameter (inches) <u>2"</u>			
(2) total depth (feet) <u>105'</u>			
(3) static water level (feet) <u>63'</u> below top of ground.			
(4) casing <u>Plastic</u> , <u>100'</u> (material) (depth)			
(size) If telescope see back.			
(5) screen <u>5</u> , <u>100'</u> (length) (depth to top)			
<u>2"</u> , <u>Plastic</u> (size) (material)			
(6) pump <u>1/2</u> , <u>5'</u> (HP) (yield gpm)			
<u>Elect</u> (type power)			
(7) electric log <u>no</u> (yes or no)			
(organization running log)			
(8) how well bottom plugged <u>Capped</u>			
DRILLERS REMARKS:			


RECEIVED

JAN 5 1977

MISS. BD. OF WATER COMM.

If well telescopes please sketch and show depths.

GROUND LEVEL

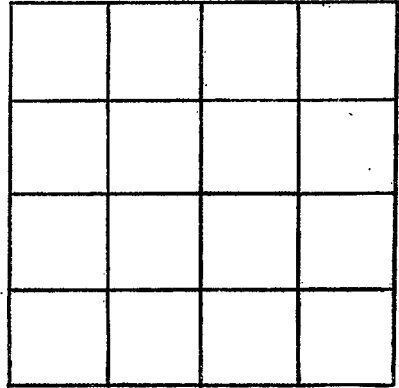

SECTION _____

Please indicate well location X.

ADDITIONAL INFORMATION

If more than one screen, show locations of each on sketch.