

STONE
D 2003
7-11-77

MISSISSIPPI
BOARD OF WATER COMMISSIONERS
416 North State Street
130 Jackson, Mississippi 39201

WATER WELL DRILLERS LOG

7-11 1977
date well completed

Pernell Anderson
firm name

Stone
county well located


LANDOWNER:	description of formations encountered	from	to
Bill Jones (mailing address)	Top Soil	0	2
	Fine Sand	2	15
WELL LOCATION: sec 27 T 2 N R 10 E S W 10 miles E of Wagon (distance) (direction) (nearest town)	Coarse Sand	15	35
WELL PURPOSE: POUND (home, irrigation, municipal, industrial)			
WELL COMPLETION DATA: (1) diameter (inches) 2" (2) total depth (feet) 36' (3) static water level (feet) 17' below top of ground. (4) casing Plastic, 30' (material) (depth) (size) If telescope see back. (5) screen 5' C 30' (length) (depth to top) 2" Plastic (size) (material) (6) pump 1 (HP) 9 (yield gpm) Elect (type power) (7) electric log No (yes or no) (organization running log) (8) how well bottom plugged Capped			
DRILLERS REMARKS:			

RECEIVED
AUG 5 1977

MISS. BD. OF WATER COMMISSIONERS

If well telescopes please sketch and show depths.

GROUND LEVEL

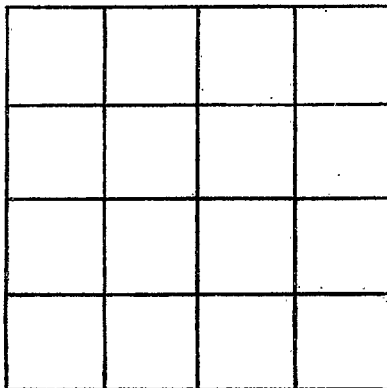

SECTION _____

Please indicate well location X.

ADDITIONAL INFORMATION

If more than one screen, show locations of each on sketch.