

Stone  
D 2004  
11/4/77

MISSISSIPPI  
BOARD OF WATER COMMISSIONERS  
416 North State Street  
Jackson, Mississippi 39201

WATER WELL DRILLERS LOG

11-4 1977 Parnell Anderson Stone  
date well completed firm name county well located


LANDOWNER:	description of formations encountered	from	to
Gerald Miller			
(mailing address)	Course Sand	3	18
WELL LOCATION:	Blue Clay	18	38
sec. 33 T 2 S R 9 E W	Fin Sand	38	75
15 miles E of W. Leake	Coarse Sand	75	82
(distance) (direction) (nearest town)			
WELL PURPOSE: HOME			
(home, irrigation, municipal, industrial)			
WELL COMPLETION DATA:			
(1) diameter (inches) 2"			
(2) total depth (feet) 82'			
(3) static water level (feet) 6' below top of ground.			
(4) casing Plastic 77' (material) (depth)			
(size) if telescope see back.			
(5) screen 5" 77' (length) (depth to top)			
2 Plastic (size) (material)			
(6) pump 1 (HP) 17 (yield gpm)			
Elect (type power)			
(7) electric log no (yes or no)			
(organization running log)			
(8) how well bottom plugged Capped			
DRILLERS REMARKS:			

RECEIVED  
DEC 6 1977

MISS. BD. OF WATER COMM

If well telescopes please sketch and show depths.

GROUND LEVEL

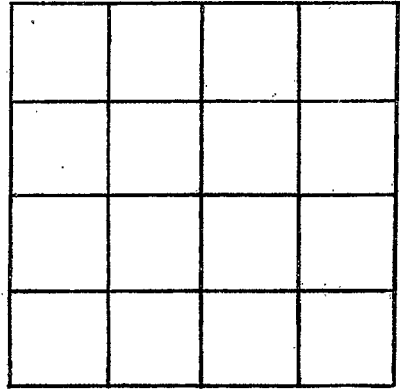

SECTION \_\_\_\_\_

Please indicate well location X.

ADDITIONAL INFORMATION

If more than one screen, show locations of each on sketch.