

Stone
D 2005
11/8/77

MISSISSIPPI
BOARD OF WATER COMMISSIONERS
416 North State Street
Jackson, Mississippi 39201

WATER WELL DRILLERS LOG

11-8 1977 Stone
date well completed firm name county well located


LANDOWNER:	description of formations encountered	from	to
<u>Ronnie Reeves</u>			
(mailing address)	<u>Coarse Sand</u>	<u>3</u>	<u>34</u>
WELL LOCATION:	<u>Blue Clay</u>	<u>34</u>	<u>133</u>
sec. <u>8</u> T. <u>2</u> N. S. R. <u>9</u> W.	<u>Medium Sand</u>	<u>133</u>	<u>150</u>
<u>15</u> miles <u>E</u> of <u>Wiggins</u>			
(distance) (direction) (nearest town)			
WELL PURPOSE: <u>HOME</u>			
(home, irrigation, municipal, industrial)			
WELL COMPLETION DATA:			
(1) diameter (inches) <u>2"</u>			
(2) total depth (feet) <u>150'</u>			
(3) static water level (feet) <u>40'</u> below top of ground.			
(4) casing <u>Plastic</u> <u>145'</u>			
(material) (depth)			
(size) if telescope see back.			
(5) screen <u>5'</u> <u>145'</u>			
(length) (depth to top)			
<u>2"</u> <u>Plastic</u>			
(size) (material)			
(6) pump <u>1</u> <u>10</u>			
(HP) (yield gpm)			
<u>Elect</u>			
(type power)			
(7) electric log <u>No</u>			
(yes or no)			
(organization running log)			
(8) how well bottom plugged <u>Capped</u>			
DRILLERS REMARKS:			

RECEIVED
DEC 6 1977

MISS. BD. OF WATER COMM

If well telescopes please sketch and show depths.

GROUND LEVEL

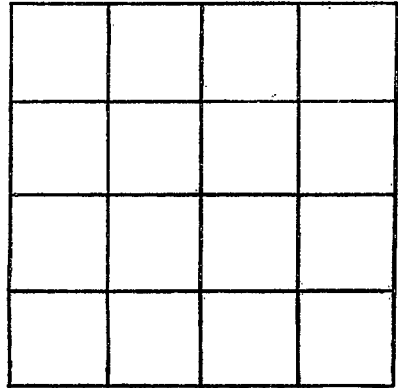

SECTION _____

Please indicate well location X.

ADDITIONAL INFORMATION

If more than one screen, show locations of each on sketch.