

STONE
D 2000
10-12-78

MISSISSIPPI
BOARD OF WATER COMMISSIONERS
416 North State Street
Jackson, Mississippi 39201

WATER WELL DRILLERS LOG


10-12-1978 Parrell Anderson Stone
date well completed firm name county well located

LANDOWNER:	description of formations encountered	from	to
<u>Yed Cain</u>	<u>Top Soil</u>	0	2
(mailing address)	<u>Red Clay</u>	2	10
WELL LOCATION: sec. <u>28</u> T <u>2</u> R <u>10</u> E <u>9</u> miles <u>E</u> of <u>Wiggins</u> (distance) (direction) (nearest town)	<u>Course Sand</u>	10	18
WELL PURPOSE: <u>HOME</u> (home, irrigation, municipal, industrial)	<u>Clay</u>	18	65
WELL COMPLETION DATA:	<u>Fine Sand</u>	65	90
(1) diameter (inches) <u>2"</u>	<u>Medium Sand</u>	90	97
(2) total depth (feet) <u>97'</u>			
(3) static water level (feet) <u>35'</u> below top of ground.			
(4) casing <u>Plastic</u> <u>92'</u> (material) (depth)			
(size) If telescope see back.			
(5) screen <u>5"</u> <u>92'</u> (length) (depth to top)			
(size) <u>2"</u> <u>Plastic</u> (material)			
(6) pump <u>1</u> <u>10</u> (HP) (yield gpm)			
(type power) <u>Elect</u>			
(7) electric log <u>no</u> (yes or no)			
(organization running log)			
(8) how well bottom plugged <u>Capped</u>			
DRILLERS REMARKS:			

RECEIVED
NOV - 1 1978
MISS. Bd. OF WATER COMMISSIONERS

If well telescopes please sketch and show depths.

GROUND LEVEL

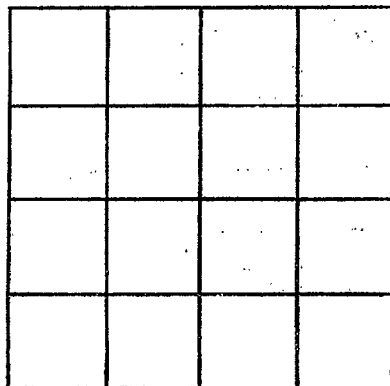

SECTION _____

Please indicate well location X.

ADDITIONAL INFORMATION

If more than one screen,
show locations of each on sketch.