

STONE  
 D 2007  
 04-19-79

MISSISSIPPI  
 BOARD OF WATER COMMISSIONERS  
 416 North State Street  
 Jackson, Mississippi 39201

WATER WELL DRILLERS LOG

4-19 1979 Barnell Anderson Stone  
 date well completed firm name county well located


LANDOWNER:	description of formations encountered	from	to
<u>Sam Morris</u>	<u>Top Soil</u>	<u>0</u>	<u>2</u>
(mailing address)	<u>Clay</u>	<u>2</u>	<u>25</u>
WELL LOCATION:	<u>Fine Sand</u>	<u>25</u>	<u>64</u>
sec. <u>34T3N</u> R <u>10E</u> <u>9</u> miles <u>S.E.</u> of <u>Wiggins</u> (distance) (direction) (nearest town)	<u>Coarse Sand</u>	<u>64</u>	<u>84</u>
WELL PURPOSE: <u>HOME</u> (home, irrigation, municipal, industrial)			
WELL COMPLETION DATA:			
(1) diameter (inches) <u>2"</u>			
(2) total depth (feet) <u>84'</u>			
(3) static water level (feet) <u>38</u> below top of ground			
(4) casing <u>Plastic 79'</u> (material) (depth)			
_____ if telescope see back. (size)			
(5) screen <u>5"</u> , <u>79'</u> (length) (depth to top)			
<u>2"</u> , <u>Plastic</u> (size) (material)			
(6) pump <u>1</u> <u>10</u> (HP) (yield gpm)			
<u>Elect.</u> (type power)			
(7) electric log <u>no</u> (yes or no)			
_____ (organization running log)			
(8) how well bottom plugged <u>Capped</u>			
DRILLERS REMARKS:			

Miss. Board of Water Comm.

MAY - 7 1979

If well telescopes please sketch and show depths.

GROUND LEVEL

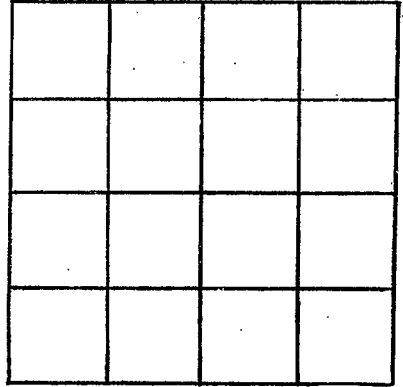

SECTION \_\_\_\_\_

Please indicate well location X.

ADDITIONAL INFORMATION

If more than one screen, show locations of each on sketch.