

Stone
D 2009
9-17-79

MISSISSIPPI
BOARD OF WATER COMMISSIONERS
416 North State Street
Jackson, Mississippi 39201

WATER WELL DRILLERS LOG

9-17-79 date well completed
Braden Pump & Well Service, Inc. firm name
Stone county well located

LANDOWNER: Amos Catchot
BL 1

Wiggins, MS 39577 (mailing address)
Clay
Sand & gravel
Clay
Sand

description of formations encountered	from	to
Clay	0	20
Sand & gravel	20	40
Clay	40	100
Sand	100	150

WELL LOCATION:
sec. 8 T. 2 N. R. 10 E.
S. W.
7 miles E of Wiggins
(distance) (direction) (nearest town)

WELL PURPOSE: Home
(home, irrigation, municipal, industrial)

- WELL COMPLETION DATA:
- (1) diameter (inches) 4"
 - (2) total depth (feet) 150'
 - (3) static water level (feet) 55 below top of ground.
 - (4) casing PVC (material), total (depth)
4" (size) if telescope see back.
 - (5) screen 10 ft (length), 130' (depth to top)
4" (size), 008 PVC underdrain (material)
 - (6) pump 1 HP (HP), 20 (yield gpm)
220 V (type power)
 - (7) electric log no (yes or no)
(organization running log)
 - (8) how well bottom plugged 2" B. Wash
check

DRILLERS REMARKS:
10' tail pipe


DEPT. OF NATURAL RESOURCES
BUREAU OF LAND & WATER RESOURCES

JAN 14 1980

RECEIVED

If well telescopes please sketch and show depths.

GROUND LEVEL

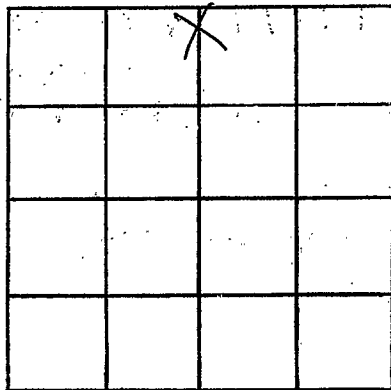

SECTION 8

Please indicate well location X.

ADDITIONAL INFORMATION

If more than one screen, show locations of each on sketch.