

Stone
D 201d
S-15-80

MISSISSIPPI
BOARD OF WATER COMMISSIONERS
416 North State Street
Jackson, Mississippi 39201

WATER WELL DRILLERS LOG

5-15-80 date well completed 1980 firm name Pennell Peterson Stone county well located

LANDOWNER:	description of formations encountered	from	to
<u>Dunwood Stephens</u>	<u>Top Soil</u>	<u>0</u>	<u>2</u>
(mailing address)	<u>Shred</u>	<u>2</u>	<u>35</u>
WELL LOCATION:	<u>Clay</u>	<u>35</u>	<u>45</u>
sec <u>5</u> T <u>2</u> R <u>10</u>	<u>Sand Fine</u>	<u>45</u>	<u>81</u>
<u>10</u> miles <u>E</u> of <u>Wiggins</u>	<u>Course Sand</u>	<u>81</u>	<u>96</u>
(distance) (direction) (nearest town)			
WELL PURPOSE: <u>HOME</u>			
(home, irrigation, municipal, industrial)			
WELL COMPLETION DATA:			
(1) diameter (inches) <u>2"</u>			
(2) total depth (feet) <u>96'</u>			
(3) static water level (feet) <u>14'</u> below top of ground.			
(4) casing <u>Plastic</u> , <u>91'</u> (material), (depth)			
(size) If telescope see back.			
(5) screen <u>5'</u> , <u>91'</u> (length), (depth to top)			
<u>2"</u> , <u>Plastic</u> (size), (material)			
(6) pump <u>1</u> , <u>12</u> (HP), (yield gpm)			
<u>Elect</u> (type power)			
(7) electric log <u>no</u> (yes, or no)			
(organization running log)			
(8) how well bottom plugged <u>Capred</u>			
DRILLERS REMARKS:			


DEPT. OF NATURAL RESOURCES
BUREAU OF LAND & WATER RESOURCES

JUN 4 - 1980

RECEIVED

If well telescopes please sketch and show depths.

GROUND LEVEL

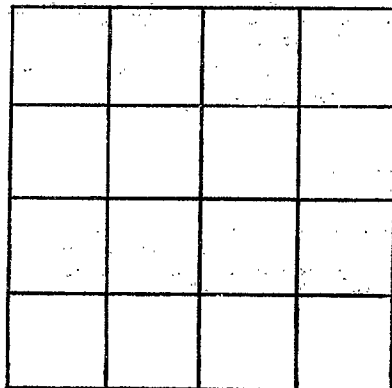

SECTION _____

Please indicate well location X.

ADDITIONAL INFORMATION

If more than one screen,
show locations of each on sketch.