

Stone
 D 2013
 9-15-80
 9-15-80

MISSISSIPPI
 BOARD OF WATER COMMISSIONERS
 416 North State Street
 Jackson, Mississippi 39201

WATER WELL DRILLERS LOG

9-15-80 date well completed
 Farnell Anderson firm name
 Stone county well located

LANDOWNER: Herby Beckham
 Rt 3
 Perhinstown, Ms
 (mailing address)

WELL LOCATION:
 sec. 5 T. 2 N R. 10 E
 S W
 12.6 miles E of Wiggins
 (distance) (direction) (nearest town)

WELL PURPOSE: Home
 (home, irrigation, municipal, industrial)

WELL COMPLETION DATA:

- (1) diameter (inches) 2"
- (2) total depth (feet) 85'
- (3) static water level (feet) 16' below top of ground.
- (4) casing Plates 32'
 (material) (depth)
 (size) if telescope see back.
- (5) screen 51', 32'
 (length) (depth to top)
 (size) (material)
- (6) pump 1 (HP) 12 (yield gpm)
 Submersible
 (type power)
- (7) electric log NO
 (yes or no)
 (organization running log)
- (8) how well bottom plugged Capped

Description of formations encountered	from	to
Top soil	0	2
Sand	2	26
Clay	26	54
Fine Sand	54	68
Coarse Sand	68	85

DEPT. OF NATURAL RESOURCES
 BUREAU OF LAND & WATER RESOURCES


OCT 14 1980

RECEIVED

DRILLERS REMARKS:

If well telescopes please
sketch and show depths.

GROUND LEVEL

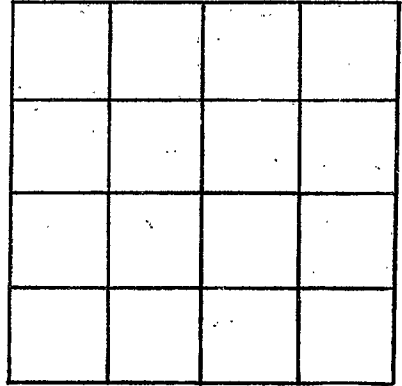

SECTION _____

Please indicate well location X.

ADDITIONAL INFORMATION

If more than one screen,
show locations of each on sketch.