

Stone
 D2014
 8-22-80

MISSISSIPPI
 BOARD OF WATER COMMISSIONERS
 416 North State Street
 Jackson, Mississippi 39201

WATER WELL DRILLERS LOG

8-22-1980 date well completed
 80 Parnell Anderson firm name
 Stone county well located

LANDOWNER: <u>Hattie Tillman</u>	description of formations encountered	from	to
<u>Wiggins, Mrs.</u> (mailing address)			
WELL LOCATION: sec. <u>17</u> T. <u>2</u> N. R. <u>9</u> E <u>2</u> S. W.	<u>Clay</u>	<u>2</u>	<u>29</u>
<u>18</u> miles <u>E</u> of <u>Wiggins</u> (distance) (direction) (nearest town)	<u>Fine sand</u>	<u>29</u>	<u>34</u>
WELL PURPOSE: <u>Home</u> (home, irrigation, municipal, industrial)	<u>Coarse sand</u>	<u>34</u>	<u>41</u>
WELL COMPLETION DATA: (1) diameter (inches) <u>2"</u>			
(2) total depth (feet) <u>261'</u>			
(3) static water level (feet) <u>32</u> below top of ground.			
(4) casing <u>Plastic</u> <u>26'</u> (material) (depth)			
(size) if telescope see back.			
(5) screen <u>5'</u> <u>26'</u> (length) (depth to top)			
(size) (material)			
(6) pump <u>1</u> <u>10</u> (HP) (yield gpm)			
<u>Electric</u> (type power)			
(7) electric log <u>NO</u> (yes or no)			
(organization running log)			
(8) how well bottom plugged <u>Capped</u>			
DRILLERS REMARKS:			


DEPT. OF NATURAL RESOURCES
 BUREAU OF LAND & WATER RESOURCES

OCT 14 1980

RECEIVED

If well telescopes please sketch and show depths.

GROUND LEVEL

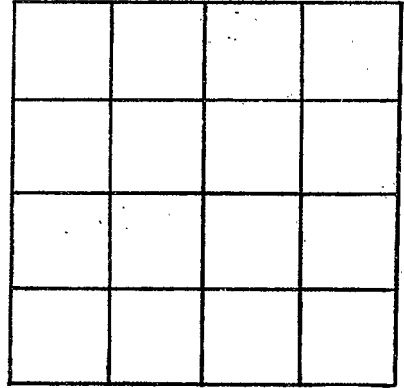

SECTION _____

Please indicate well location X.

ADDITIONAL INFORMATION

If more than one screen,
show locations of each on sketch.