

STONE
D 2015
11-5-80

MISSISSIPPI
BOARD OF WATER COMMISSIONERS
416 North State Street
Jackson, Mississippi 39201

WATER WELL DRILLERS LOG

11-5
date well completed

1980 Farnell Anderson
firm name

Stone
county well located

LANDOWNER: Austin Cooper

description of formations encountered

from

to

Rt 1 Box 68c
Weygina MS
(mailing address)

top soil	0	3
clay	3	26
sand	26	32
clay	32	46
clear sand	46	59

WELL LOCATION:

sec. 35 T. 2 S. R. 10 W.
13 miles E of Weygina
(distance) (direction) (nearest town)

WELL PURPOSE: home
(home, irrigation, municipal, industrial)

WELL COMPLETION DATA:

- (1) diameter (inches) 2"
- (2) total depth (feet) 59'
- (3) static water level (feet) 28' below top of ground.
- (4) casing Plastic 54' (material) (depth)
2" (size) if telescope see back.
- (5) screen 5' 54' (length) (depth to top)
2" Plastic (size) (material)
- (6) pump 1 11 (HP) (yield gpm)
Electric (type power)
- (7) electric log NO (yes or no)
- (organization running log)
- (8) how well bottom plugged Capped

DRILLERS REMARKS:


DEPT. OF NATURAL RESOURCES
BUREAU OF LAND & WATER RESOURCES

JAN 12 1981

RECEIVED

If well telescopes please
sketch and show depths.

GROUND LEVEL

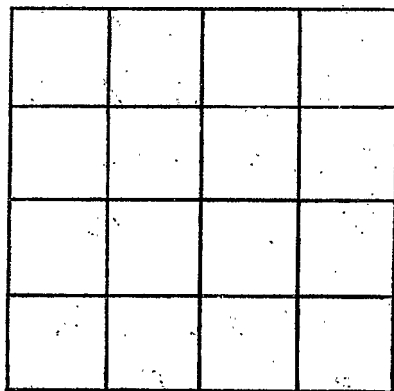

SECTION _____

Please indicate well location X.

ADDITIONAL INFORMATION

If more than one screen,
show locations of each on sketch.