

STONE  
 D JOSE  
 12-9-80

MISSISSIPPI  
 BOARD OF WATER COMMISSIONERS  
 416 North State Street  
 Jackson, Mississippi 39201

WATER WELL DRILLERS LOG

12-9 date well completed 1980 Parson Anderson Stone  
 firm name county well located

LANDOWNER: Leroy Parker

description of formations encountered

from to

Rt 3  
 Purkinator, MS 39573  
 (mailing address)

Top Soil	0	3
Clay	3	17
Sand	17	28
Clay	28	34
Coarse Sand	34	42

WELL LOCATION:

sec. 34 T 2 S R. 10 W  
 12 miles E of Wiggins  
 (distance) (direction) (nearest town)

WELL PURPOSE: Home  
 (home, irrigation, municipal, industrial)

WELL COMPLETION DATA:

- (1) diameter (inches) 2"
- (2) total depth (feet) 42'
- (3) static water level (feet) 25' below top of ground.
- (4) casing Plastic 37"  
 (material) (depth)  
2" if telescope see back.  
 (size)
- (5) screen 5' 37'  
 (length) (depth to top)  
2 Plastic  
 (size) (material)
- (6) pump 1 12  
 (HP) (yield gpm)  
Electric  
 (type power)
- (7) electric log NO  
 (yes or no)

(organization running log)

(8) how well bottom plugged Capped

DRILLERS REMARKS:


DEPT. OF NATURAL RESOURCES  
 BUREAU OF LAND & WATER RESOURCES

JAN 12 1981

RECEIVED

If well telescopes please  
sketch and show depths.

GROUND LEVEL

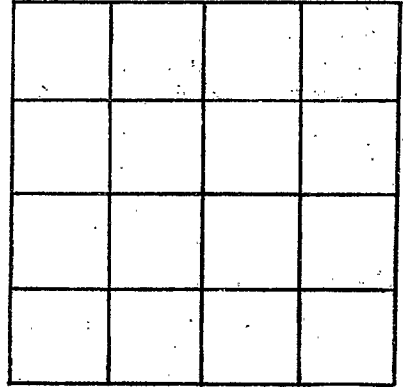

SECTION \_\_\_\_\_

Please indicate well location X.

ADDITIONAL INFORMATION

If more than one screen,  
show locations of each on sketch.