

STONE
D 2017
12-23-80
12-23 1980

MISSISSIPPI
BOARD OF WATER COMMISSIONERS
416 North State Street
Jackson, Mississippi 39201

WATER WELL DRILLERS LOG

date well completed firm name county well located

LANDOWNER: Pearl River Valley, Inc.

description of formations encountered	from	to
Top soil	0	2
clay	2	28
Sand	28	32
clay	32	58
Fine Sand	58	60
Coarse sand	60	81

O.O. Box 249
Wiggins, MS 39577
(mailing address)

WELL LOCATION:

sec 20 T 2 S R 10 W
10 miles E of Wiggins
(distance) (direction) (nearest town)

WELL PURPOSE: home
(home, irrigation, municipal, industrial)

WELL COMPLETION DATA:

- (1) diameter (inches) 2"
- (2) total depth (feet) 82'
- (3) static water level (feet) 28' below top of ground
- (4) casing Plastic 47'
(material) (depth)
2" (size) if telescope see back.
- (5) screen 5' 77'
(length) (depth to top)
2" Plastic
(size) (material)
- (6) pump 1 12
(HP) (yield gpm)
Electric
(type power)
- (7) electric log NO
(yes or no)

(organization running log)

(8) how well bottom plugged Capped

DRILLERS REMARKS:


DEPT. OF NATURAL RESOURCES
BUREAU OF LAND & WATER RESOURCES

JAN 12 1981

RECEIVED

If well telescopes please sketch and show depths.

GROUND LEVEL

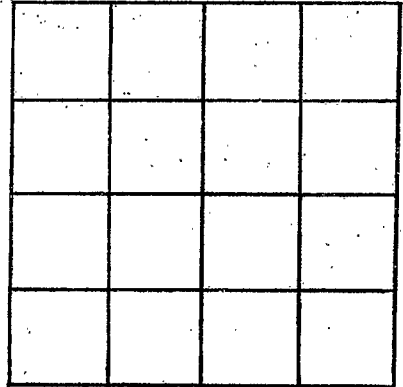

SECTION _____

Please indicate well location X.

ADDITIONAL INFORMATION

If more than one screen, show locations of each on sketch.