

Stone  
D 202  
7-27-81

MISSISSIPPI  
BOARD OF WATER COMMISSIONERS  
416 North State Street  
Jackson, Mississippi 39201

WATER WELL DRILLERS LOG  
BRADEN PUMP AND WELL SERVICE, INC.  
7-27-81 19 ROUTE 1, BOX 489 Stone  
date well completed SAUCIER, MS 39574 county well located

LANDOWNER:  
JOHNNY HALL  
Rt 1, Box 83  
Wiggins, MS 39577  
(mailing address)


| description of formations encountered | from | to  |
|---------------------------------------|------|-----|
| CLAY                                  | 0    | 15  |
| SAND                                  | 15   | 25  |
| CLAY                                  | 25   | 85  |
| SAND                                  | 85   | 100 |

WELL LOCATION:  
sec. 8 T 2 N R 9 E  
S W  
(distance) (direction) (nearest town)  
5 miles W of Beandale

WELL PURPOSE: home  
(home, irrigation, municipal, industrial)


- WELL COMPLETION DATA:
- diameter (inches) 2"
  - total depth (feet) 100
  - static water level (feet) 35 below top of ground.
  - casing PVC total  
(material) (depth)  
2" if telescope see back.  
(size)
  - screen 10 85  
(length) (depth to top)  
2" PVC under bar  
(size) (material)
  - pump 1 14  
(HP) (yield gpm)  
230  
(type power)
  - electric log NO  
(yes or no)
- (organization running log)
- (8) how well bottom plugged 2" SAND SHARP

DRILLERS REMARKS:  
5' tail pipe

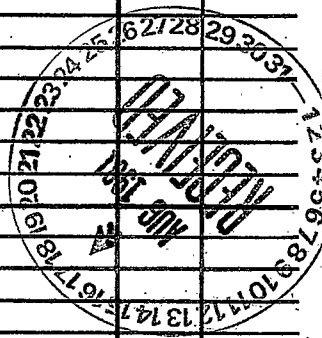

If well telescopes please sketch and show depths.

GROUND LEVEL

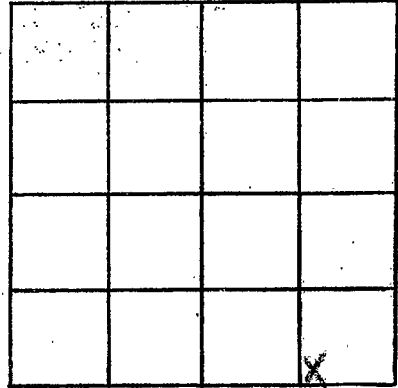

SECTION 8

Please indicate well location X.

ADDITIONAL INFORMATION

If more than one screen, show locations of each on sketch.