

MISSISSIPPI DEPARTMENT OF NATURAL RESOURCES

Bureau of Land and Water Resources

Southport Mall

P.O. Box 10631

Jackson, Mississippi 39209

WATER WELL DRILLERS LOG

| |
|--------|
| Stone |
| D 2009 |
| 9-1-81 |

9-1-81 date well completed 1981 firm name Parnell Anderson Stone county well located

LANDOWNER: Pearl River Valley Surf. Inc.
P.O. Box 249
Wiggins, MS
 (mailing address)

| description of formations encountered | from | to |
|---------------------------------------|------|----|
| Top soil | 0 | 3 |
| Clay | 3 | 24 |
| Sand | 24 | 38 |
| Clay | 38 | 65 |
| Sand | 65 | 82 |

WELL LOCATION:
 sec 30 T-2 R 10
6 1/2 miles SE of Wiggins
 (distance) (direction) (nearest town)

WELL PURPOSE: Home
 (home, irrigation, municipal, industrial)

WELL COMPLETION DATA:

(1) diameter (inches) 2 1/4"

(2) total depth (feet) 82'

(3) static water level (feet) 30' below above top of ground

(4) casing PVC 74'
 (material) (depth)

_____ If telescope see back.
 (size)

(5) screen 5' 77'
 (length) (depth to top)

2" PVC
 (size) (material)

(6) pump 1 11
 (HP) (yield gpm)

Electric
 (type power)

(7) electric log NO
 (yes or no)

_____ (organization running log)

(8) how well bottom plugged Capped

DRILLERS REMARKS:


DEPT. OF NATURAL RESOURCES
 BUREAU OF LAND & WATER RESOURCES

OCT - 2 1981

RECEIVED

If well telescopes please sketch and show depths.

GROUND LEVEL

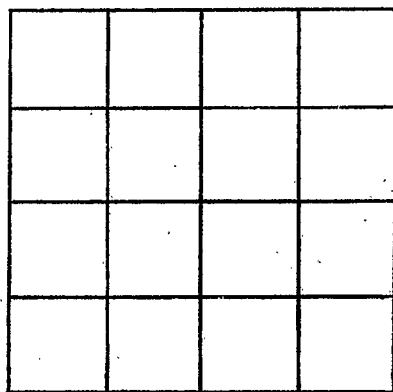

SECTION _____

Please indicate well location X.

ADDITIONAL INFORMATION

If more than one screen,
show locations of each on sketch.