

MISSISSIPPI DEPARTMENT OF NATURAL RESOURCES  
 Bureau of Land and Water Resources  
 Southport Mall  
 P.O. Box 10631

Jackson, Mississippi 39209  
**WATER WELL DRILLERS LOG**

**BRADEN PUMP AND WELL SERVICE, INC**

Stone  
D 2021  
10/12/81

10-12-81 19 STONE  
 date well completed ROUTE 1, BOX 489 county well located  
SAUCIER, MS firm name 39574

**LANDOWNER:**  
Angus Catchott  
At. 1

W. qains, MS 39577  
 (mailing address)

**WELL LOCATION:**  
 sec. PT 2 N R 10 E  
3 W  
7 1/2 miles E of W. qain  
 (distance) (direction) (nearest town)

**WELL PURPOSE:** home  
 (home, irrigation, municipal, industrial)

**WELL COMPLETION DATA:**

(1) diameter (inches) 4"

(2) total depth (feet) 640

(3) static water level (feet) 95 below above top of ground.

(4) casing PVC, total (material) (depth)  
640 (size) if telescope see back.

(5) screen 20, 600 (length) (depth to top)  
4", PVC underbar (size) (material)

(6) pump 1, 20 (HP) (yield gpm)  
530 (type power)

(7) electric log NO (yes or no)

(organization running log)

(8) how well bottom plugged 2 1/2" sand shark

description of formations encountered	from	to
SAND	0	10
CLAY	10	20
SAND	20	30
CLAY	30	118
SAND	118	125
CLAY	125	135
SAND	135	145
<del>SAND</del> CLAY	145	300
SAND	300	310
CLAY	310	440
SAND	440	460
SAND + CLAY	460	480
CLAY	480	500
SAND - fine	500	595
SAND - good	595	635

DEPT. OF NATURAL RESOURCES  
 BUREAU OF LAND & WATER RESOURCES  
 RECEIVED  
 OCT 20 1981


**DRILLERS REMARKS:**  
20' tail pipe

If well telescopes please sketch and show depths.

GROUND LEVEL

81 OCT 29 A 9:11

RECEIVED

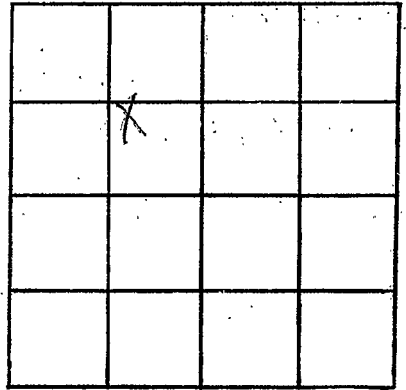

SECTION 19

Please indicate well location X.

ADDITIONAL INFORMATION

If more than one screen, show locations of each on sketch.