

Stone
 D
 10/29/81

MISSISSIPPI
 BOARD OF WATER COMMISSIONERS
 416 North State Street
 Jackson, Mississippi 39201

WATER WELL DRILLERS LOG

Oct 29 1981 81 Farnell Anderson Stone
 date well completed firm name county well located

LANDOWNER	description of formations encountered	from	to
<u>Amanda Church</u>	<u>Top soil</u>	<u>0</u>	<u>3</u>
<u>Rt 1 Box 116</u>	<u>Clay</u>	<u>3</u>	<u>28</u>
<u>Wiggins, MS 39519</u>	<u>sand</u>	<u>28</u>	<u>36</u>
(mailing address)	<u>Clay</u>	<u>36</u>	<u>40</u>
	<u>sand</u>	<u>40</u>	<u>60</u>

WELL LOCATION:
 sec. 8 T 2 S R 10 W
5 miles E of Wiggins
 (distance) (direction) (nearest town)

WELL PURPOSE: Church
 (home, irrigation, municipal, industrial)

- WELL COMPLETION DATA:
- (1) diameter (inches) 2"
 - (2) total depth (feet) 60'
 - (3) static water level (feet) 65' below top of ground.
 - (4) casing PVC, 55'
 (material) (depth)
 - (size) if telescope see back.
 - (5) screen 5, 55'
 (length) (depth to top)
2", PVC
 (size) (material)
 - (6) pump 1, 7
 (HP) (yield gpm)
Electric
 (type power)
 - (7) electric log NO
 (yes or no)
 - (organization running log)
 - (8) how well bottom plugged Capped

DEPT. OF NATURAL RESOURCES
 BUREAU OF LAND & WATER RESOURCES


DEC 30 1991

RECEIVED

DRILLERS REMARKS:

If well telescopes please sketch and show depths.

GROUND LEVEL

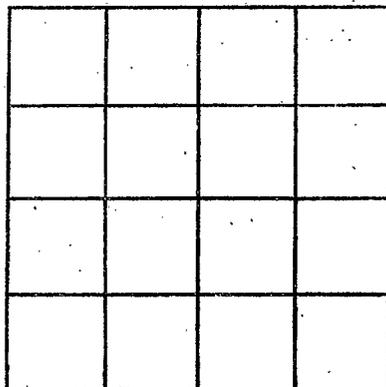

SECTION _____

Please indicate well location X.

ADDITIONAL INFORMATION

If more than one screen,
show locations of each on sketch.