

MISSISSIPPI DEPARTMENT OF NATURAL RESOURCES

Bureau of Land and Water Resources

Southport Mall

P.O. Box 10631

Jackson, Mississippi 39209

WATER WELL DRILLERS LOG

Stone

D 2003

9-8
date well completed

Frank Price
firm name

Stone
county well located

LANDOWNER:	description of formations encountered	from	to
<u>Eddie Alexander</u>	<u>Top Soil</u>	<u>0</u>	<u>2</u>
(mailing address)	<u>Clay</u>	<u>2</u>	<u>40</u>
WELL LOCATION:	<u>Hard Sand</u>	<u>40</u>	<u>65</u>
sec <u>22</u> T <u>2</u> R <u>100</u>	<u>Coarse Sand</u>	<u>65</u>	<u>80</u>
<u>3 1/2</u> miles <u>E</u> of <u>Whitson Crossing</u>			
(distance) (direction) (nearest town)			
WELL PURPOSE: <u>HOME</u> (home, irrigation, municipal, industrial)			
WELL COMPLETION DATA:			
(1) diameter (inches) <u>2"</u>			
(2) total depth (feet) <u>80'</u>			
(3) static water level (feet) <u>40'</u> below top of ground.			
(4) casing <u>Plastic, 75'</u> (material) (depth)			
(size) If telescope see back.			
(5) screen <u>5'</u> , <u>75'</u> (length) (depth to top)			
<u>2"</u> , <u>Plastic</u> (size) (material)			
(6) pump <u>1</u> , <u>9</u> (HP) (yield gpm)			
<u>Elect</u> (type power)			
(7) electric log <u>No</u> (yes or no)			
(organization running log)			
(8) how well bottom plugged <u>Capped</u>			
DRILLERS REMARKS:			


DEPT. OF NATURAL RESOURCES
BUREAU OF LAND & WATER RESOURCES

MAR 23 1992

RECEIVED

If well telescopes please sketch and show depths.

GROUND LEVEL

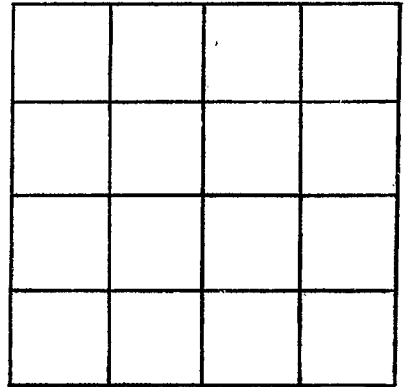

SECTION _____

Please indicate well location X.

ADDITIONAL INFORMATION

If more than one screen,
show locations of each on sketch.