

MISSISSIPPI DEPARTMENT OF NATURAL RESOURCES

Bureau of Land and Water Resources

Southport Mall

P.O. Box 10631

Jackson, Mississippi 39209

WATER WELL DRILLERS LOG

Stone
D 2004

4-21
date well completed

1982 Frank Price
firm name

Stone
county well located

LANDOWNER:
John Taylor
(mailing address)

description of formations encountered	from	to
Top Soil	0	2
Sandy clay	2	25
Course Sand	25	80

WELL LOCATION:
sec 35 T 2 N R 10 E
S
4 1/2 miles SE of Whites Crossing
(distance) (direction) (nearest town)

WELL PURPOSE: HOME
(home, irrigation, municipal, industrial)

WELL COMPLETION DATA:

(1) diameter (inches) 4"

(2) total depth (feet) 80'

(3) static water level (feet) 30' below top of ground.

(4) casing Plastic 75'
(material) (depth)

(size) If telescope see back.

(5) screen 5' 75'
(length) (depth to top)

4" Plastic
(size) (material)

(6) pump 1 30
(HP) (yield gpm)

Elect
(type power)

(7) electric log no
(yes or no)

(organization running log)

(8) how well bottom plugged
Capped

DRILLERS REMARKS:


DEPT. OF NATURAL RESOURCES
BUREAU OF LAND & WATER RESOURCES

MAY 10 1982

RECEIVED

If well telescopes please sketch and show depths.

GROUND LEVEL

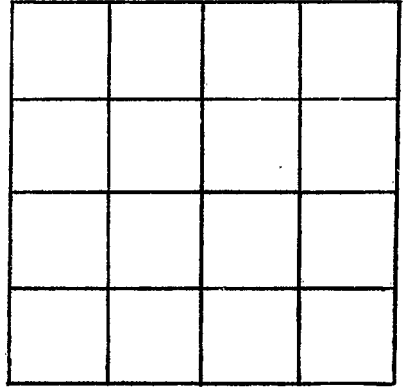

SECTION _____

Please indicate well location X.

ADDITIONAL INFORMATION

If more than one screen, show locations of each on sketch.