

Stone
D 2015

MISSISSIPPI
BOARD OF WATER COMMISSIONERS
416 North State Street
Jackson, Mississippi 39201

WATER WELL DRILLERS LOG

March 26 1982 Palmer Anderson Stone
date well completed firm name county well located

LANDOWNER: Lena Fairley
Rt 1, Box 117
Wiggins, MS
(mailing address)

description of formations encountered	from	to
Top soil	0	3
Clay	3	24
sand	24	68
Clay	68	90
sand	90	113

WELL LOCATION:
sec. 5 T. 2 S. R. 10 W.
15 miles E of Wiggins
(distance) (direction) (nearest town)

WELL PURPOSE: home
(home, irrigation, municipal, industrial)

- WELL COMPLETION DATA:
- (1) diameter (inches) 2"
 - (2) total depth (feet) 113'
 - (3) static water level (feet) 50' below top of ground.
 - (4) casing PVC (material) (depth) _____
(size) if telescope see back.
 - (5) screen 5' (length) 108' (depth to top)
2" (size) PVC (material)
 - (6) pump 1 (HP) 6 (yield gpm)
Electric (type power)
 - (7) electric log NO (yes or no)
(organization running log) _____
 - (8) how well bottom plugged Copper

DEPT. OF NATURAL RESOURCES
BUREAU OF LAND & WATER RESOURCES


JUN - 9 1982

RECEIVED

DRILLERS REMARKS:

If well telescopes please sketch and show depths.

GROUND LEVEL

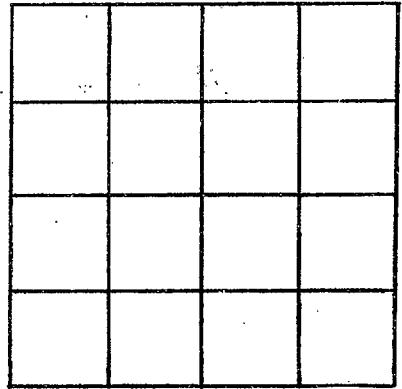

SECTION _____

Please indicate well location X.

ADDITIONAL INFORMATION

If more than one screen,
show locations of each on sketch.