

MISSISSIPPI DEPARTMENT OF NATURAL RESOURCES

Bureau of Land and Water Resources

Southport Mall

P.O. Box 10631

Jackson, Mississippi 39209

WATER WELL DRILLERS LOG

|         |
|---------|
| Stone   |
| D 2007  |
| 4-16-85 |
|         |

4-16 1985 date well completed      Frank Price firm name      Stone county well located

LANDOWNER: Harbert Easterland  
 (mailing address)


| description of formations encountered | from      | to        |
|---------------------------------------|-----------|-----------|
| <u>Top Soil</u>                       | <u>0</u>  | <u>3</u>  |
| <u>Red clay</u>                       | <u>3</u>  | <u>15</u> |
| <u>Medium Sand</u>                    | <u>15</u> | <u>53</u> |

WELL LOCATION:  
 sec. 33 T. 2 S. R. 10  
3/4 miles N.E. of Paramount Church  
 (distance) (direction) (nearest town)

WELL PURPOSE: HOME  
 (home, irrigation, municipal, industrial)

- WELL COMPLETION DATA:
- (1) diameter (inches) 2"
  - (2) total depth (feet) 53'
  - (3) static water level (feet) 40' below top of ground.
  - (4) casing PVC, 48' (material) (depth)
  - (size) If telescope see back.
  - (5) screen 5' 48' (length) (depth to top)
  - 2" PVC (size) (material)
  - (6) pump 1 6 (HP) (yield gpm)
  - Elect (type power)
  - (7) electric log no (yes or no)
  - (organization running log)
  - (8) how well bottom plugged BWV


DRILLERS REMARKS:

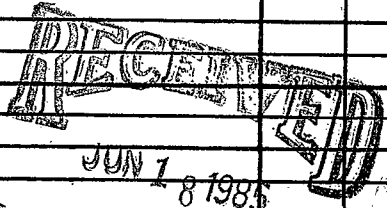

Department of Natural Resources  
 Bureau of Land & Water Resources

If well telescopes please sketch and show depths.

GROUND LEVEL

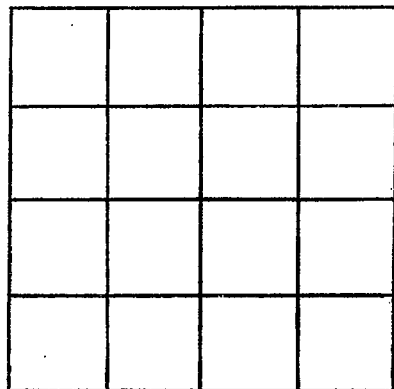

SECTION \_\_\_\_\_

Please indicate well location X.

ADDITIONAL INFORMATION

If more than one screen, show locations of each on sketch.